

**WATER WELL PLUGGING RECORD Form WWC-5P**

**KM-08-110**  
KSA 82a-1212 ID NO.

**1 LOCATION OF WATER WELL:** Fraction  $\frac{1}{4}$   $\frac{1}{4}$  SW  $\frac{1}{4}$  SE  $\frac{1}{4}$  Section Number 31 Township Number T 17 S Range Number 9  E  W  
County: Ellsworth


Street/Rural Address of Well Location; if unknown, distance & direction from nearest town or intersection: If at owner's address, check here  OneOK Facility (Kinder Morgarn) 777 Y Avenue Bushton KS 67427

**Global Positioning Systems (GPS) information:**  
Latitude: 38.522166 (in decimal degrees)  
Longitude: -98.35760 (in decimal degrees)  
Elevation: \_\_\_\_\_  
Horizontal Datum:  WGS84,  NAD83,  NAD27  
Collection Method: \_\_\_\_\_

**2 WATER WELL OWNER:** KMI  
RR#, St. Address, Box #: 1001 Louisiana Street  
City, State ZIP Code: Houston TX 77002

GPS unit (Make/Model): Garmin etrek  
 Digital Map/Photo,  Topographic Map,  Land Survey  
Est. Accuracy:  < 3 m,  3-5 m,  5-15 m,  > 15 m

**3 MARK WELL'S LOCATION WITH AN "X" IN SECTION BOX:**

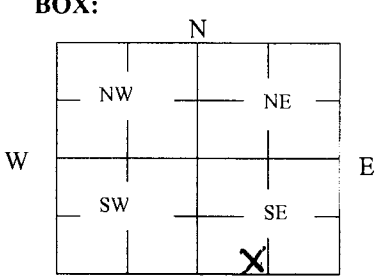

**4 DEPTH OF WELL** 31.5 ft.  
WELL'S STATIC WATER LEVEL \_\_\_\_\_ ft.  
WELL WAS USED AS:  
 Domestic  Public Water Supply  Dewatering  
 Irrigation  Oil Field Water Supply  Monitoring  
 Feedlot  Domestic (Lawn & Garden)  Injection Well  
 Industrial  Air Conditioning  Other \_\_\_\_\_  
Was a chemical/bacteriological sample submitted to Department? Yes  No

**5 TYPE OF BLANK CASING USED:**  
 Steel  RMP (SR)  Wrought  Fiberglass  Other (Specify below)  
 PVC  ABS  Asbestos-Cement  Concrete Tile \_\_\_\_\_  
Blank casing diameter 2 in. Was casing pulled? Yes  No  If yes, how much all \_\_\_\_\_  
Casing height above or below land surface -6 in.

**6 GROUT PLUG MATERIAL:**  Neat cement  Cement grout  Bentonite  Other Top Soil  
Grout Plug Intervals: From 0 ft. to 3 ft., From 3 ft. to 31.5 ft., From - ft. to - ft.

What is the nearest source of possible contamination:  
 Septic tank  Seepage pit  Fuel storage  Other (specify below) \_\_\_\_\_  
 Sewer lines  Pit privy  Fertilizer storage \_\_\_\_\_  
 Watertight sewer lines  Sewage lagoon  Insecticide storage \_\_\_\_\_  
 Lateral lines  Feedyard  Abandoned water well Direction from well? \_\_\_\_\_  
 Cess pool  Livestock pens  Oil well/Gas well How many feet? \_\_\_\_\_

FROM	TO	PLUGGING MATERIALS	FROM	TO	PLUGGING MATERIALS
0	3	Top Soil			
3	31.5	Bentonite			


**7 CONTRACTOR'S OR LANDOWNER'S CERTIFICATION:** This water well was plugged under my jurisdiction and was completed on (mo/day/year) 7-27-16 and this record is true to the best of my knowledge and belief. Kansas Water Well Contractor's License No. 710. This Water Well Record was completed on (mo/day/year) 8-1-16 under the business name of Below Ground Surface, Inc. by (signature) Michael T. Osody

Send one white copy to Kansas Department of Health & Environment, Geology Section, 1000 SW Jackson Street, Ste. 420, Topeka, KS 66612-1367. Send one copy to WATER WELL OWNER and retain one for your records.  
Visit us at <http://www.kdheks.gov/waterwell/index.html> Telephone 785-296-5524.



Source: Esri, DigitalGlobe, GeoEye, Earthstar Geographics, CNES/Airbus DS, USDA, USGS, AEX, GeoEye, IGN, GP Swisstopo, and the GIS User Community

**LEGEND**  
 ◆ Well Plugging Location  
 ▨ Waste Pit

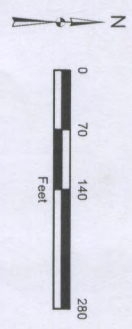

CBI ENVIRONMENTAL & INFRASTRUCTURE, INC.  
 1530 W. 35th Street  
 WICHITA, KANSAS 67205  
 (316) 220-8020

**PROPOSED WELL  
 PLUGGING LOCATIONS  
 PCE TANK AREA**

CLIENT:  
 KINDER MORGAN, INC.

LOCATION:  
 BUSHTON, KS

FIGURE:  
 9