

WATER WELL PLUGGING RECORD Form WWC-5P

KSA 82a-1212

ID NO.

OB 123


1 LOCATION OF WATER WELL: County: <u>Ellsworth</u>	Fraction <u>¼ SW ¼ SW ¼ SW ¼</u>	Section Number <u>31</u>	Township Number <u>T 17 S</u>	Range Number <u>9</u> <input type="checkbox"/> E <input checked="" type="checkbox"/> W
--	-------------------------------------	-----------------------------	----------------------------------	---

Street/Rural Address of Well Location; if unknown, distance & direction from nearest town or intersection: If at owner's address, check here OneOK Hydrocarbon Facility/Kinder Morgan 777 Y Ave. Bushton, KS 67427

Global Positioning Systems (GPS) information:
Latitude: 38.34194 (in decimal degrees)
Longitude: -98.12277 (in decimal degrees)
Elevation: _____
Horizontal Datum: WGS84, NAD83, NAD27
Collection Method: _____

2 WATER WELL OWNER: KMI
RR#, St. Address, Box #: 1001 Louisiana St.
City, State ZIP Code: Houston, TX 77002

GPS unit (Make/Model: Garmin etrek)
 Digital Map/Photo, Topographic Map, Land Survey
Est. Accuracy: < 3 m, 3-5 m, 5-15 m, > 15 m

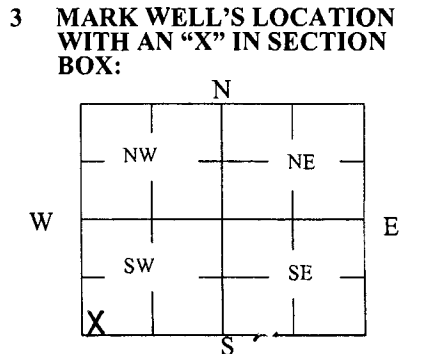

4 DEPTH OF WELL 25 ft.
WELL'S STATIC WATER LEVEL 18.08 ft.
WELL WAS USED AS:
 Domestic Public Water Supply Dewatering
 Irrigation Oil Field Water Supply Monitoring
 Feedlot Domestic (Lawn & Garden) Injection Well
 Industrial Air Conditioning Other _____
Was a chemical/bacteriological sample submitted to Department? Yes No

5 TYPE OF BLANK CASING USED:
 Steel RMP (SR) Wrought Fiberglass Other (Specify below)
 PVC ABS Asbestos-Cement Concrete Tile
Blank casing diameter 2 in. Was casing pulled? Yes No If yes, how much all _____
Casing height above or below land surface 30 in.

6 GROUT PLUG MATERIAL: Neat cement Cement grout Bentonite Other Top Soil
Grout Plug Intervals: From 0 ft. to 3 ft., From 3 ft. to 25 ft., From — ft. to — ft.
What is the nearest source of possible contamination:
 Septic tank Seepage pit Fuel storage Other (specify below) _____
 Sewer lines Pit privy Fertilizer storage unknown
 Watertight sewer lines Sewage lagoon Insecticide storage _____
 Lateral lines Feedyard Abandoned water well Direction from well? unknown
 Cess pool Livestock pens Oil well/Gas well How many feet? unknown

FROM	TO	PLUGGING MATERIALS	FROM	TO	PLUGGING MATERIALS
0	3	Top Soil			
3	25	Bentonite			

7 CONTRACTOR'S OR LANDOWNER'S CERTIFICATION: This water well was plugged under my jurisdiction and was completed on (mo/day/year) 03/12/2018 and this record is true to the best of my knowledge and belief. Kansas Water Well Contractor's License No. 710. This Water Well Record was completed on (mo/day/year) 03/15/2018 under the business name of Below Ground Surface, Inc. by (signature) Craig R. Miller

Send one white copy to Kansas Department of Health & Environment, Geology Section, 1000 SW Jackson Street, Ste. 420, Topeka, KS 66612-1367. Send one copy to WATER WELL OWNER and retain one for your records.
Visit us at <http://www.kdheks.gov/waterwell/index.html> Telephone 785-296-5524.