

**1 LOCATION OF WATER WELL:** County: Ellsworth Fraction NE 1/4 NW 1/4 SW 1/4 SE 1/4 Section Number 31 Township Number T 17 S Range Number 9  E  W

Street/Rural Address of Well Location; if unknown, distance & direction from nearest town or intersection: If at owner's address, check here  400 feet north of West Flare at 777 Ave. Y, Bushton KS

**Global Positioning Systems (GPS) information:**  
 Latitude: 38.524977 (in decimal degrees)  
 Longitude: -98.358165 (in decimal degrees)  
 Elevation: \_\_\_\_\_  
 Horizontal Datum:  WGS84,  NAD83,  NAD27  
 Collection Method: \_\_\_\_\_

**2 WATER WELL OWNER:** OneOK Field Svcs - KMorgan  
 RR#, St. Address, Box #: 777 Avenue Y  
 City, State ZIP Code: Bushton KS 67427

GPS unit (Make/Model: Garmin etrek)  
 Digital Map/Photo,  Topographic Map,  Land Survey  
 Est. Accuracy:  < 3 m,  3-5 m,  5-15 m,  > 15 m

**3 MARK WELL'S LOCATION WITH AN "X" IN SECTION BOX:**

**4 DEPTH OF WELL** 20 ft.  
 WELL'S STATIC WATER LEVEL \_\_\_\_\_ ft  
 WELL WAS USED AS:  
 Domestic  Public Water Supply  Dewatering  
 Irrigation  Oil Field Water Supply  Monitoring  
 Feedlot  Domestic (Lawn & Garden)  Injection Well  
 Industrial  Air Conditioning  Other \_\_\_\_\_  
 Was a chemical/bacteriological sample submitted to Department? Yes  No

**5 TYPE OF BLANK CASING USED:**

Steel  RMP (SR)  Wrought  Fiberglass  Other (Specify below)  
 PVC  ABS  Asbestos-Cement  Concrete Tile

Blank casing diameter 2 in. Was casing pulled? Yes  No  If yes, how much all  
 Casing height above or below land surface 30 in.

**6 GROUT PLUG MATERIAL:**  Neat cement  Cement grout  Bentonite  Other Top Soil

Grout Plug Intervals: From 0 ft. to 3 ft., From 3 ft. to 20 ft., From — ft. to — ft.

What is the nearest source of possible contamination:  
 Septic tank  Seepage pit  Fuel storage  Other (specify below)  
 Sewer lines  Pit privy  Fertilizer storage  
 Watertight sewer lines  Sewage lagoon  Insecticide storage  
 Lateral lines  Feedyard  Abandoned water well Direction from well? east  
 Cess pool  Livestock pens  Oil well/Gas well How many feet? 400

FROM	TO	PLUGGING MATERIALS	FROM	TO	PLUGGING MATERIALS
0	3	Top Soil			
3	20	Bentonite			

**7 CONTRACTOR'S OR LANDOWNER'S CERTIFICATION:** This water well was plugged under my jurisdiction and was completed on (mo/day/year) 04/02/2019 and this record is true to the best of my knowledge and belief. Kansas Water Well Contractor's License No. 710. This Water Well Record was completed on (mo/day/year) 04/05/2019 under the business name of Below Ground Surface, Inc. by (signature) Craig Keffewer

Send one white copy to Kansas Department of Health & Environment, Geology Section, 1000 SW Jackson Street, Ste. 420, Topeka, KS 66612-1367. Send one copy to WATER WELL OWNER and retain one for your records.  
 Visit us at <http://www.kdheks.gov/waterwell/index.html> Telephone 785-296-5524.



1950 S. FLORENCE  
WICHITA, KANSAS 67209  
(316) 943-3444

**Shaw Environmental, Inc.**

Site Id: KM-OB-117

Date Started: 12/09/04

Project Name: KinderMorgan	Coordinate X: -1696.92	Blank Casing: type:PVC dia:2.00in fm:-3.0' to:5.00'
Project Number:	Coordinate Y: 895.25	
Location: Flare Pit	Static Water Level:	Screens: type:Slotted size:0.010in dia: 2.00in fm:5.00' to:20.00'
Logged By: D. White	Measuring Point: 1740.37'	
Contractor: Whitetail	Total Depth: 20.00'	Annular Fill: type: Concrete fm:0.00' to:2.00' type: Bentonite fm:2.00' to:4.00' type: Sand Pack fm:4.00' to:20.00'
Drilling Method: HSA	Borehole Dia.: 7.75in	
Remarks: Above ground		Completed Depth: 20.00'


Depth	Well Construction	Water Level	% Recovery	PID	Sample No.	USCS Code	Graphic Log	Material Description
0-1'			100			FL		0-1' FILL, topsoil, dark brown silty clay, moist to wet.
1-8.5'			100	0.0 ppm		CL		1-8.5' silty CALY, dark yellow brown, stiff, plastic, moist, with trace sand.
8.5-16.25'			100	0.0 ppm		ML		8.5-16.25' clayey SILT, yellow brown, with fine sand, soft, wet, non-plastic.
16.25-20'			75					16.25-20' sandy SILT, yellow brown, saturated, soft, non-plastic, clayey from 17-18', with manganese concretions.
END OF EXPLORATION @ 20'								



ELLSWORTH

SE SE NW

sec 31 T17S R9W

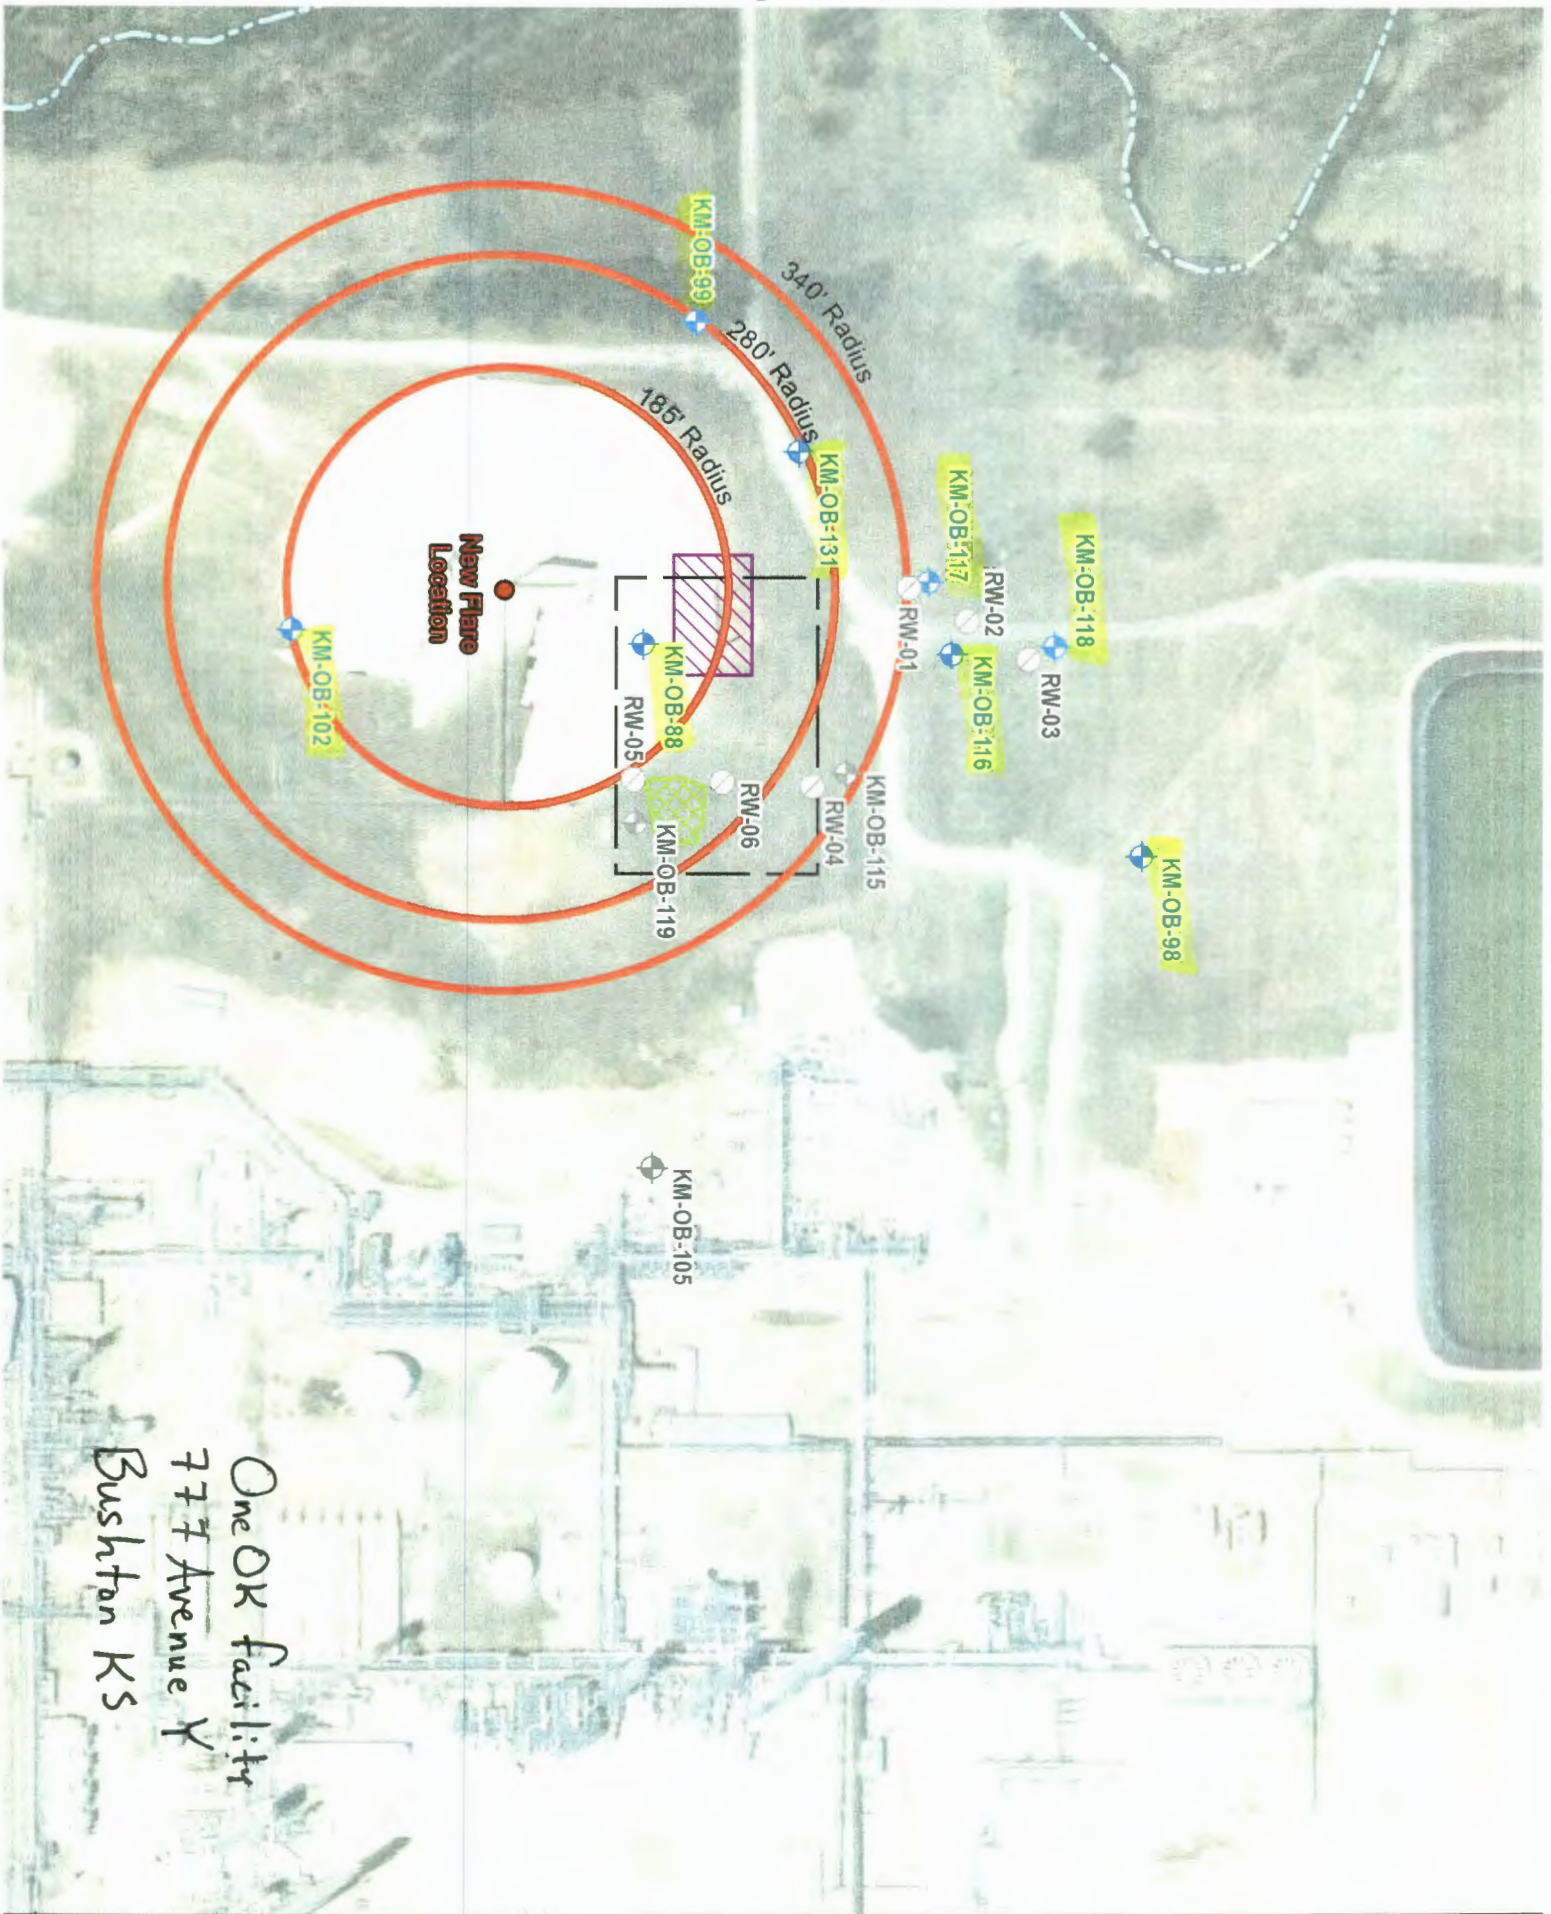

One OR facility  
 777 Avenue Y  
 Bushston KS

