

**WATER WELL PLUGGING RECORD Form WWC-5P**

KSA 82a-1212

ID NO.

**KM-08-102**

**1 LOCATION OF WATER WELL:** Fraction SE 1/4 NW 1/4 SW 1/4 SE 1/4 Section Number 31 Township Number T 17 S Range Number 9  E  W  
 County: Ellsworth


Street/Rural Address of Well Location; if unknown, distance & direction from nearest town or intersection: If at owner's address, check here  South side of West Flare area at 777 Y Ave.; Bushton KS

**Global Positioning Systems (GPS) information:**  
 Latitude: 38.523513 (in decimal degrees)  
 Longitude: -98.358014 (in decimal degrees)  
 Elevation: 1746  
 Horizontal Datum:  WGS84,  NAD83,  NAD27  
 Collection Method:

**2 WATER WELL OWNER:** OneOK Field Svcs - KMorgan  
 RR#, St. Address, Box #: 777 Avenue Y  
 City, State ZIP Code: Bushton KS 67427

GPS unit (Make/Model): Garmin etrek  
 Digital Map/Photo,  Topographic Map,  Land Survey  
 Est. Accuracy:  < 3 m,  3-5 m,  5-15 m,  > 15 m

**3 MARK WELL'S LOCATION WITH AN "X" IN SECTION BOX:**

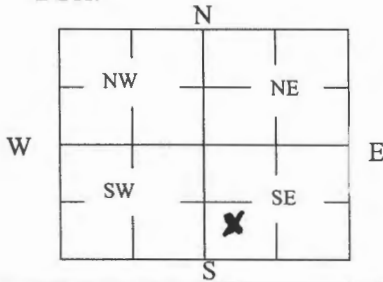

**4 DEPTH OF WELL** 20 ft.

WELL'S STATIC WATER LEVEL \_\_\_\_\_ ft

WELL WAS USED AS:

- Domestic
- Public Water Supply
- Dewatering
- Irrigation
- Oil Field Water Supply
- Monitoring
- Feedlot
- Domestic (Lawn & Garden)
- Injection Well
- Industrial
- Air Conditioning
- Other \_\_\_\_\_

Was a chemical/bacteriological sample submitted to Department? Yes  No

**5 TYPE OF BLANK CASING USED:**

- Steel
- RMP (SR)
- Wrought
- Fiberglass
- Other (Specify below) \_\_\_\_\_
- PVC
- ABS
- Asbestos-Cement
- Concrete Tile

Blank casing diameter 2 in. Was casing pulled? Yes  No  If yes, how much all  
 Casing height above or below land surface 30 in.

**6 GROUT PLUG MATERIAL:**  Neat cement  Cement grout  Bentonite  Other Top Soil

Grout Plug Intervals: From 0 ft. to 3 ft., From 3 ft. to 20 ft., From — ft. to — ft.

What is the nearest source of possible contamination:

- Septic tank
  - Seepage pit
  - Fuel storage
  - Other (specify below) \_\_\_\_\_
  - Sewer lines
  - Pit privy
  - Fertilizer storage
  - Watertight sewer lines
  - Sewage lagoon
  - Insecticide storage
  - Lateral lines
  - Feedyard
  - Abandoned water well
  - Cess pool
  - Livestock pens
  - Oil well/Gas well
- Direction from well? east  
 How many feet? 600 feet

FROM	TO	PLUGGING MATERIALS	FROM	TO	PLUGGING MATERIALS
0	3	Top Soil			
3	20	Bentonite			

**7 CONTRACTOR'S OR LANDOWNER'S CERTIFICATION:** This water well was plugged under my jurisdiction and was completed on (mo/day/year) 04/02/2019 and this record is true to the best of my knowledge and belief. Kansas Water Well Contractor's License No. 710. This Water Well Record was completed on (mo/day/year) 04/05/2019 under the business name of Below Ground Surface, Inc. by (signature) Craig R. Keffner


Send one white copy to Kansas Department of Health & Environment, Geology Section, 1000 SW Jackson Street, Ste. 420, Topeka, KS 66612-1367. Send one copy to WATER WELL OWNER and retain one for your records.  
 Visit us at <http://www.kdheks.gov/waterwell/index.html> Telephone 785-296-5524.



ELLSWORTH

SE SE NW

sec 31 T17S R9W

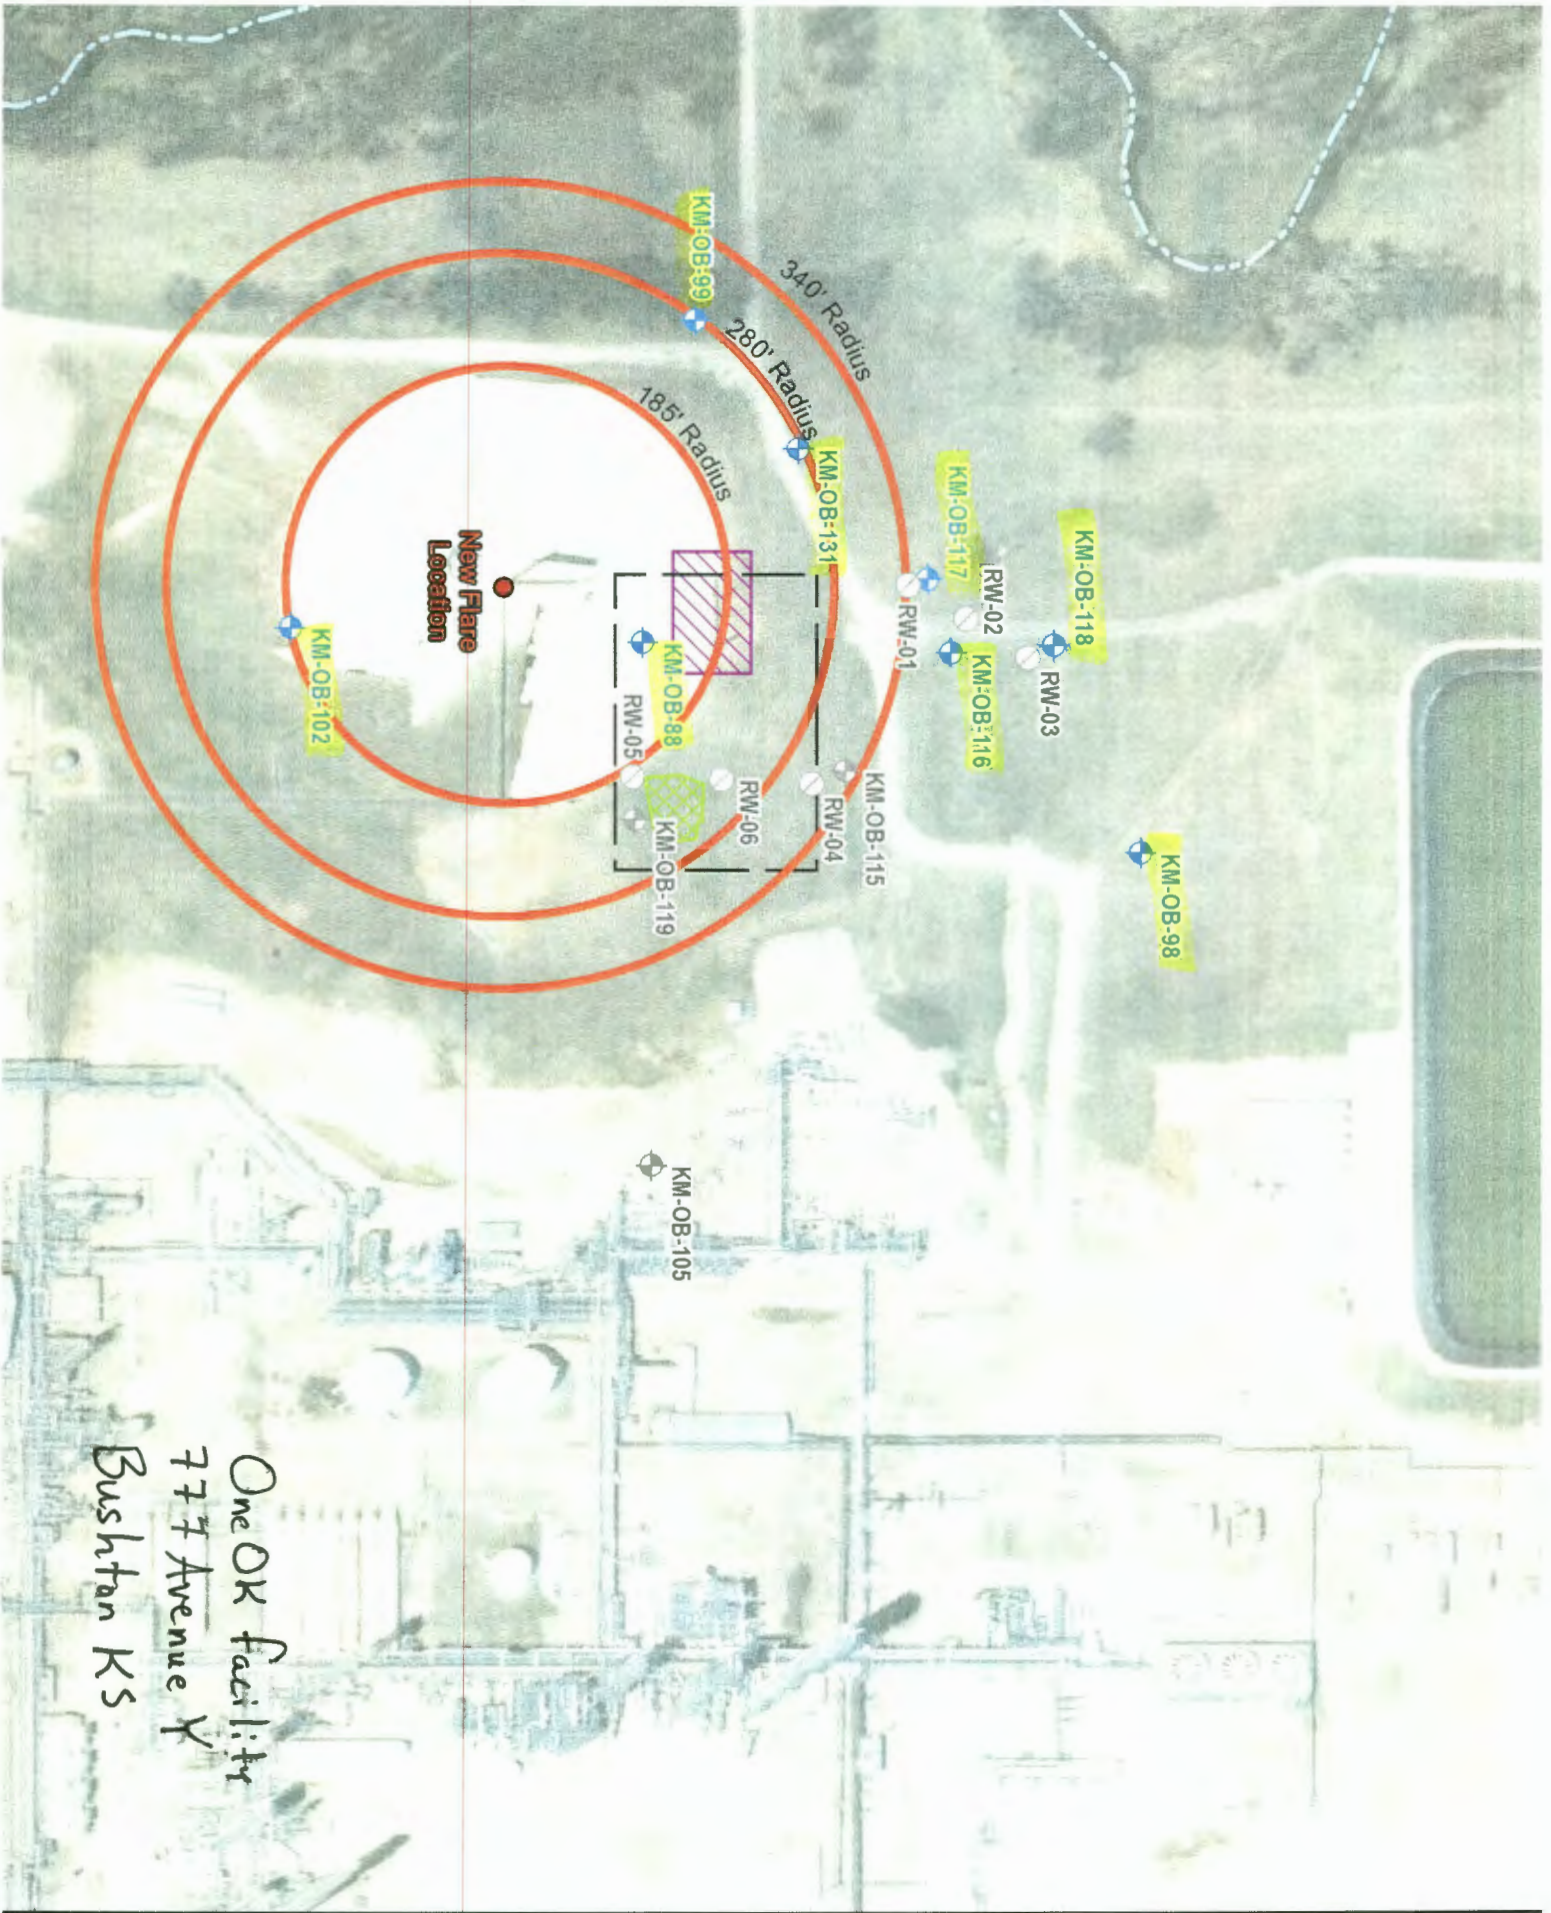

One OK facility  
 777 Avenue Y  
 Bushston KS

