USE TYPEWRITER OR BALL POINT PEN-PRESS FIRMLY, PRINT CLEARLY.

WATER WELL RECORD
KSA 82a-1201-1215

Kansas Department of Health and Environment-Division of Environment
(Water well Contractors)
Topeka, Kansas 66620

1. Location of well:	County	Fraction	Section number	Township number	Range number
	McPHERSON	NW SE 1/4 NW 1/4 NW 1/4	11	T - 19 - S	R - 1 - E/W

2. Distance and direction from nearest town or city: 35-1E of Roxbury
Street address of well location if in city: [redacted]

3. Owner of well: DANNY WATSON
R.R. or street: Box 1082
City, state, zip code: HESSTON KANSAS 67062

4. Locate with "X" in section below: Sketch map:

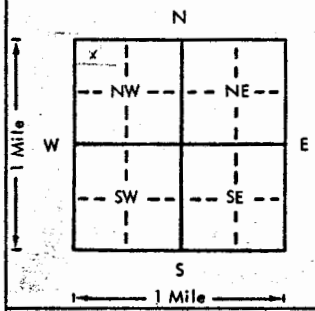

6. Bore hole dia. 8 in. Completion date
Well depth 45 ft. 12-22-77

7. ___ Cable tool X Rotary ___ Driven ___ Dug
___ Hollow rod ___ Jetted ___ Bored ___ Reverse rotary

8. Use: X Domestic ___ Public supply ___ Industry
___ Irrigation ___ Air conditioning ___ Stock
___ Lawn ___ Oil field water ___ Other

9. Casing: Material ___ Height: (Above) or below
Threaded ___ Welded X Surface 12 in.
RMP ___ PVC X Weight 1¼ lbs./ft.
Dia. 4 in. to 45 ft. depth Wall Thickness: inches or
Dia. ___ in. to ___ ft. depth gage No. 1/4

5. Type and color of material	From	To
Top soil	0	5
Buff clay	5	8
Very fine sand	8	12
Creek gravel	12	19
Grey shale	19	45

10. Screen: Manufacturer's name Peerless Plastics
Type PVC Dia. 4
Slot/gauze V.32" Length 20'
Set between 1 ft. and 22 ft.
ft. and ft.
Gravel pack? Yes Size range of material 1/4"

11. Static water level: mo./day/yr.
7 ft. below land surface Date 12/22/77

12. Pumping level below land surfaces:
8 ft. after 1½ hrs. pumping 12 g.p.m.
___ ft. after ___ hrs. pumping ___ g.p.m.
Estimated maximum yield 15-20 g.p.m.

13. Water sample submitted: mo./day/yr.
___ Yes X No Date

14. Well head completion:
X Pitless adapter ___ Inches above grade

15. Well grouted? Yes
With: X Neat cement ___ Bentonite ___ Concrete
Depth: From 4 ft. to 14 ft.

16. Nearest source of possible contamination:
ft. 1500 Direction West Type Horses
Well disinfected upon completion? X Yes ___ No

17. Pump: X Not installed
Manufacturer's name
Model number HP Volts
Length of drop pipe ft. capacity g.p.m.
Type:
___ Submersible ___ Turbine
___ Jet ___ Reciprocating
___ Centrifugal ___ Other

(Use a second sheet if needed)

18. Elevation:

Topography:
___ Hill
X Slope
___ Upland
___ Valley

19. Remarks:

RECEIVED
JAN 19 1978
DIVISION OF ENVIRONMENT
OF & EG SEC.

20. Water well contractor's certification:
This well was drilled under my jurisdiction and this report is true to the best of my knowledge and belief.
Peterson Irrigation 138A
Business name License No.
Address Box 150 Lindsborg, KS
Signed Mike Chambers Date 1-10-78
Authorized representative

Forward the white, blue and pink copies to the Department of Health and Environment

Form WWC-5

T 19 R 1 E Sec 11 NW NW NW 1/4 1/4 1/4