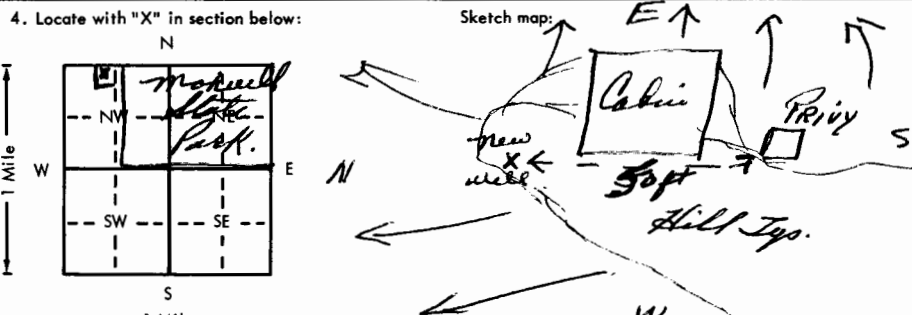


USE TYPEWRITER OR BALL POINT PEN—PRESS FIRMLY, PRINT CLEARLY.

WATER WELL RECORD  
KSA 82a-1201-1215

Kansas Department of Health and Environment—Division of Environment (Water well Contractors) Topeka, Kansas 66620

1. Location of well: County <u>McPherson</u> Fraction <u>NE 1/4 NE 1/4 NW 1/4</u> Section number <u>19</u> Township number T <u>18</u> S R <u>1</u> <span style="float:right;">(NW)</span>	
2. Distance and direction from nearest town or city: <u>3W - 7N - 1/2 E</u> 3. Owner of well: <u>Charles H Pully</u> Street address of well location if in city: <u>Canton, Kans.</u> R.R. or street: <u>1101 S. Elm</u> City, state, zip code: <u>McPherson, Kans. 67460</u>	
4. Locate with "X" in section below: 	
5. Type and color of material	
	From To
<u>Top soil</u>	0 1
<u>Sandy clays</u>	1 9
<u>Red sandy clays hard.</u>	9 11
<u>Gray clays &amp; some sandstone</u>	11 16
<u>White sandstone</u>	16 22
<u>Blue shales</u>	22 26
<u>Red sandstone some Blue shale</u>	26 35
<u>Large sandstone - Very good water bear</u>	35 57
<u>Iron Pyrites - Very hard. Marcasite</u>	57 60
<u>Loose sandstone - Very good water bear</u>	60 63
<u>Gray shales</u>	63 67
<u>Blue shale some Iron pyrites</u>	67 75
(Use a second sheet if needed)	
6. Bore hole dia. <u>8"</u> in. Completion date <u>9-16-76</u> Well depth <u>70</u> ft.	7. <input checked="" type="checkbox"/> Cable tool <input checked="" type="checkbox"/> Rotary <input type="checkbox"/> Driven <input type="checkbox"/> Dug <input type="checkbox"/> Hollow rod <input type="checkbox"/> Jetted <input type="checkbox"/> Bored <input type="checkbox"/> Reverse rotary
8. Use: <input checked="" type="checkbox"/> Domestic <input type="checkbox"/> Public supply <input type="checkbox"/> Industry <input type="checkbox"/> Irrigation <input type="checkbox"/> Air conditioning <input type="checkbox"/> Stock <input type="checkbox"/> Lawn <input type="checkbox"/> Oil field water <input type="checkbox"/> Other	9. Casing: Material <u>ALU</u> Height: <u>Above</u> or below Threaded <input type="checkbox"/> Welded <u>7/8"</u> Surface <u>18"</u> in. RMP <input type="checkbox"/> PVC <input checked="" type="checkbox"/> Weight _____ lbs./ft. Dia. <u>5"</u> in. to <u>70</u> ft. depth Wall Thickness: inches or Dia. _____ in. to _____ ft. depth gage No. <u>44"</u>
10. Screen: Manufacturer's name <u>Jet Stream</u> <u>Winrock Ins.</u> Type <u>P.V.C.</u> Dia. <u>5"</u> Slot/gauze <u>7/16</u> Length <u>44'</u> Set between <u>26</u> ft. and <u>70</u> ft. _____ ft. and _____ ft. Gravel pack? <u>yes</u> Size range of material <u>1/8-1/4</u>	11. Static water level: _____ mo./day/yr. <u>35'</u> ft. below land surface Date <u>9-16-76</u>
12. Pumping level below land surfaces: <u>40</u> ft. after <u>2</u> hrs. pumping <u>15</u> g.p.m. _____ ft. after _____ hrs. pumping _____ g.p.m. Estimated maximum yield <u>25-30</u> g.p.m.	13. Water sample submitted: _____ mo./day/yr. <input type="checkbox"/> Yes <input checked="" type="checkbox"/> No Date _____
14. Well head completion: <u>Press House</u> <input type="checkbox"/> Pitless adapter <u>18</u> inches above grade	15. Well grouted? <u>yes</u> With: <input checked="" type="checkbox"/> Neat cement <input type="checkbox"/> Bentonite <input type="checkbox"/> Concrete Depth: From <u>0</u> ft. to <u>16</u> ft.
16. Nearest source of possible contamination: ft. <u>50</u> Direction <u>SE</u> Type <u>Privy</u> Well disinfected upon completion? <input checked="" type="checkbox"/> Yes <input type="checkbox"/> No	17. Pump: <input checked="" type="checkbox"/> Not installed Manufacturer's name _____ Model number _____ HP _____ Volts _____ Length of drop pipe _____ ft. capacity _____ g.p.m. Type: <input type="checkbox"/> Submersible <input type="checkbox"/> Turbine <input type="checkbox"/> Jet <input type="checkbox"/> Reciprocating <input type="checkbox"/> Centrifugal <input type="checkbox"/> Other
18. Elevation: Topography: <input checked="" type="checkbox"/> Hill <input type="checkbox"/> Slope <input type="checkbox"/> Upland <input type="checkbox"/> Valley	19. Remarks: <u>Mr. Pully will remove Privy as soon as he modernizes Cabin. He will install his own pump.</u>
20. Water well contractor's certification: This well was drilled under my jurisdiction and this report is true to the best of my knowledge and belief. <u>Peterson D. Dine</u> License No. <u>138</u> Business name <u>Lindsborg Kans</u> Address <u>Walla Walla</u> Signed <u>Walla Walla</u> Date <u>9-16-76</u> Authorized representative	18 10E 129 NE 1/4 NW 1/4 1/4 1/4