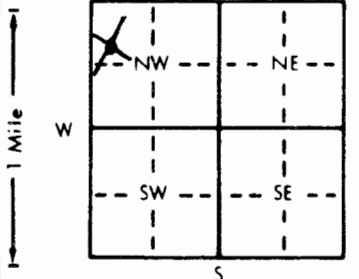


1 LOCATION OF WATER WELL:		Fraction	Section Number	Township Number	Range Number
County: McPherson		SW 1/4 NW 1/4 NW 1/4	19	T 18 S	R 1 NW
Distance and direction from nearest town or city street address of well if located within city? 3 miles West & 7 Miles North of Canton					
2 WATER WELL OWNER:		Raymond Williams			
RR#, St. Address, Box # :		Rt 2, Box 46			
City, State, ZIP Code :		Galva, KS 67448			
3 LOCATE WELL'S LOCATION WITH AN "X" IN SECTION BOX:		4 DEPTH OF COMPLETED WELL: 80 ft. ELEVATION: ft.			
		Depth(s) Groundwater Encountered 1. 60 ft. 2. ft. 3. ft.			
		WELL'S STATIC WATER LEVEL 60 ft. below land surface measured on mo/day/yr 9-27-94			
		Pump test data: Well water was ft. after hours pumping gpm			
		Est. Yield 20-30 gpm: Well water was ft. after hours pumping gpm			
		Bore Hole Diameter 8 in. to 88 ft., and in. to ft.			
WELL WATER TO BE USED AS:		5 Public water supply 8 Air conditioning 11 Injection well			
1 Domestic 3 Feedlot 6 Oil field water supply 9 Dewatering		12 Other (Specify below)			
2 Irrigation 4 Industrial 7 Lawn and garden only 10 Monitoring well		Stock			
Was a chemical/bacteriological sample submitted to Department? Yes. No. X; If yes, mo/day/yr sample was submitted					
Water Well Disinfected? Yes X No					
5 TYPE OF BLANK CASING USED:					
1 Steel 3 RMP (SR)		5 Wrought iron 8 Concrete tile		CASING JOINTS: Glued X Clamped	
2 PVC 4 ABS		6 Asbestos-Cement 9 Other (specify below)		Welded	
Blank casing diameter 5 in. to 70 ft. Dia in. to ft. Dia in. to ft.		7 Fiberglass		Threaded	
Casing height above land surface 12 in. weight 2.37 lbs./ft. Wall thickness or gauge No. .214					
TYPE OF SCREEN OR PERFORATION MATERIAL:					
1 Steel 3 Stainless steel 5 Fiberglass 7 PVC		10 Asbestos-cement			
2 Brass 4 Galvanized steel 6 Concrete tile 9 ABS		11 Other (specify)			
12 None used (open hole)					
SCREEN OR PERFORATION OPENINGS ARE:					
1 Continuous slot 3 Mill slot 5 Gauzed wrapped 8 Saw cut 11 None (open hole)		6 Wire wrapped 9 Drilled holes			
2 Louvered shutter 4 Key punched 7 Torch cut 10 Other (specify)					
SCREEN-PERFORATED INTERVALS: From 70 ft. to 80 ft. From ft. to ft.					
From ft. to ft. From ft. to ft.					
GRAVEL PACK INTERVALS: From 25 ft. to 80 ft. From ft. to ft.					
From ft. to ft. From ft. to ft.					
6 GROUT MATERIAL: 1 Neat cement 2 Cement grout 3 Bentonite 4 Other					
Grout Intervals: From 5 ft. to 25 ft. From ft. to ft. From ft. to ft.					
What is the nearest source of possible contamination:					
1 Septic tank 4 Lateral lines 7 Pit privy 10 Livestock pens 14 Abandoned water well		11 Fuel storage 15 Oil well/Gas well			
2 Sewer lines 5 Cess pool 8 Sewage lagoon 12 Fertilizer storage 16 Other (specify below)					
3 Watertight sewer lines 6 Seepage pit 9 Feedyard 13 Insecticide storage					
Direction from well? North		How many feet? 70 ft			
FROM	TO	LITHOLOGIC LOG	FROM	TO	PLUGGING INTERVALS
0	3	Top Soil			
3	14	Tan Clay			
14	29	Fine to Medium Sand			
29	31	Tan Clay			
31	48	Sandstone-Tan			
48	51	Iron Pirite			
51	88	White Sandstone			
7 CONTRACTOR'S OR LANDOWNER'S CERTIFICATION: This water well was (1) constructed, (2) reconstructed, or (3) plugged under my jurisdiction and was completed on (mo/day/year) 9-27-94 and this record is true to the best of my knowledge and belief. Kansas					
Water Well Contractor's License No. 138 This Water Well Record was completed on (mo/day/yr) 10-24-94					
under the business name of Peterson Irrigation Inc. by (signature) <i>Mike Peterson</i>					
INSTRUCTIONS: Use typewriter or ball point pen. PLEASE PRESS FIRMLY and PRINT clearly. Please fill in blanks, underline or circle the correct answers. Send top three copies to Kansas Department of Health and Environment, Bureau of Water, Topeka, Kansas 66620-0001. Telephone: 913-296-5545. Send one to WATER WELL OWNER and retain one for your records.					