


1 LOCATION OF WATER WELL: Fraction W 1/4 SE 1/4 SW 1/4 Section Number 31 Township Number 18 Range Number 10
 County: Lyon

Distance and direction from nearest town or city street address of well if located within city?

2 WATER WELL OWNER: MERIAM DIGGS
MEIERHENSEY REAL ESTATE CO.
 RR #, St. Address, Box #: 2336 SW MAYFAIR PL Board of Agriculture, Division of Water Resources
 City, State, ZIP Code: TOPEKA KS 66611 Application Number: _____

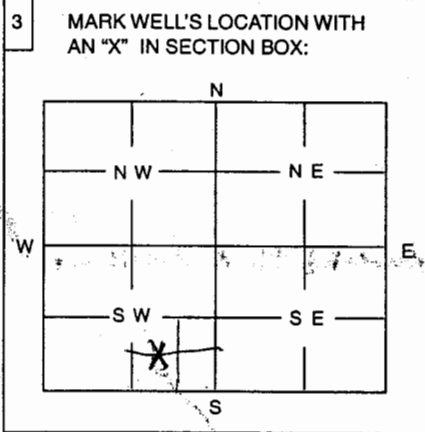

4 DEPTH OF WELL 30 ft
 WELL'S STATIC WATER LEVEL 25 ft.
 WELL WAS USED AS:
 1 Domestic 5 Public Water Supply 9 Dewatering
 2 Irrigation 6 Oil Field Water Supply 10 Monitoring Well
 3 Feedlot 7 Domestic (Lawn & Garden) 11 Injection Well
 4 Industrial 8 Air Conditioning 12 Other LIVESTOCK
 Was a chemical / bacteriological sample submitted to Department? Yes No X.....
 If yes, mo/day/yr sample was submitted
 Water Well Disinfected: Yes X..... No

5 TYPE OF BLANK CASING USED:
 1 Steel 3 RMP (SR) 5 Wrought 7 Fiberglass 9 Other (Specify below)
 2 PVC 4 ABS 6 Asbestos-Cement 8 Concrete Tile STONE
 Blank casing diameter in. Was casing pulled? Yes X..... ~~No~~..... If yes, how much 5-6 FT
 Casing height above or below land surface N/A in.

6 GROUT PLUG MATERIAL: 1 Neat cement 2 Cement grout 3 Bentonite 4 Other
 Grout Plug Intervals: From 5 ft. to 4.5 ft., From ft. to ft., From to ft.
 What is the nearest source of possible contamination:
 1 Septic tank 6 Seepage pit 11 Fuel storage 16 Other (specify below)
 2 Sewer lines 7 Pit privy 12 Fertilizer storage Stream
 3 Watertight sewer lines 8 Sewage lagoon 13 Insecticide storage
 4 Lateral lines 9 Feedyard 14 Abandoned water well
 5 Cess Pool 10 Livestock pens 15 Oil well/Gas well
 Direction from well? SELF How many feet? N/A

FROM	TO	PLUGGING MATERIALS
30	25	Rock & Chlorox
25	18	SAND
18	12	ROCK
12	10	SAND
10	5	DIRT @ 5' LAYER BENTONITE
5	+1.5	DIRT

RECEIVED
 OCT 06 2004
 BUREAU OF WATER

7 CONTRACTOR'S OR LANDOWNER'S CERTIFICATION: This water well was plugged under my jurisdiction and was completed on (mo/day/year) SEPT. 21, 2004 and this record is true to the best of my knowledge and belief. Kansas Water Well Contractor's License No. N/A This Water Well Record was completed on (mo/day/year) 21 SEPT. 04 under the business name of MEIERHENSEY REAL ESTATE by (signature) [Signature]

INSTRUCTIONS: Use typewriter or ball point pen. Please press firmly and print clearly. Please fill in blanks, underline or circle the correct answers. Send top three copies to Kansas Department of Health and Environment, Bureau of Water, Topeka, Kansas 66620-0001. Telephone: 785/296-3565. Send one to Water Well Owner and retain one for your records.