


1 LOCATION OF WATER WELL: Fraction NE 1/4 NE 1/4 NE 1/4 Section Number 12 Township Number T 18 S Range Number R 10 EW
 County: Rice

Distance and direction from nearest town or city street address of well if located within city?

1 1/2 east, 1/4 south of Bushton, Ks.

2 WATER WELL OWNER: Mike Behnke Board of Agriculture, Division of Water Resources
 RR#, St. Address, Box # : 680 B Ave
 City, State, ZIP Code : Bushton, Ks. 67427 Application Number:

3 LOCATE WELL'S LOCATION WITH AN "X" IN SECTION BOX:

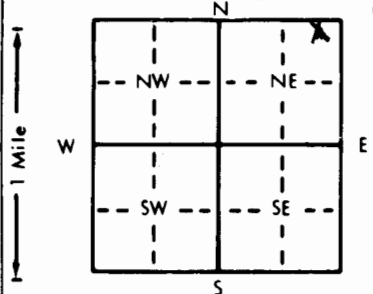

4 DEPTH OF COMPLETED WELL... 180 ft. ELEVATION:
 Depth(s) Groundwater Encountered 1. ft. 2. ft. 3. ft.
 WELL'S STATIC WATER LEVEL ... 30 ft. below land surface measured on mo/day/yr 7-11-98
 Pump test data: Well water was ft. after hours pumping gpm
 Est. Yield ... na gpm: Well water was ft. after hours pumping gpm
 Bore Hole Diameter ... 9 7/8 in. to ... 180 ft., and in. to ft.
 WELL WATER TO BE USED AS: 5 Public water supply 8 Air conditioning 11 Injection well
1 Domestic 3 Feedlot 6 Oil field water supply 9 Dewatering 12 Other (Specify below)
2 Irrigation 4 Industrial 7 Lawn and garden only 10 Monitoring well
 Was a chemical/bacteriological sample submitted to Department? Yes.....No.....x...; If yes, mo/day/yr sample was submitted
 Water Well Disinfected? Yes hth No

5 TYPE OF BLANK CASING USED: 5 Wrought iron 8 Concrete tile CASING JOINTS: Glued X Clamped
 1 Steel 3 RMP (SR) 6 Asbestos-Cement 9 Other (specify below) Welded
 2 PVC 4 ABS 7 Fiberglass Threaded.....
 Blank casing diameter ... 5" in. to ... 150 ft., Dia. in. to ft., Dia. in. to ft.
 Casing height above land surface ... 2' in., weight ... SDR 21 lbs./ft. Wall thickness or gauge No.
 TYPE OF SCREEN OR PERFORATION MATERIAL: 7 PVC 10 Asbestos-cement
 1 Steel 3 Stainless steel 5 Fiberglass 8 RMP (SR) 11 Other (specify)
 2 Brass 4 Galvanized steel 6 Concrete tile 9 ABS 12 None used (open hole)
 SCREEN OR PERFORATION OPENINGS ARE: 5 Gauzed wrapped 8 Saw cut 11 None (open hole)
 1 Continuous slot 3 Mill slot 6 Wire wrapped 9 Drilled holes
 2 Louvered shutter 4 Key punched 7 Torch cut 10 Other (specify)
 SCREEN-PERFORATED INTERVALS: From ... 150 ft. to ... 180 ft., From ft. to ft.
 From ft. to ft., From ft. to ft.
 GRAVEL PACK INTERVALS: From ... 180 ft. to ... 70 ft., From ... 66'-20 ft. to ft.
 From ft. to ft., From ft. to ft.

6 GROUT MATERIAL: 1 Neat cement 2 Cement grout 3 Bentonite 4 Other hole plug 66'-70', 20'-3'
 Grout intervals: From ft. to ft., From ft. to ft., From ft. to ft.
 What is the nearest source of possible contamination:
1 Septic tank 4 Lateral lines 7 Pit privy 10 Livestock pens 14 Abandoned water well
 2 Sewer lines 5 Cess pool 8 Sewage lagoon 11 Fuel storage 15 Oil well/Gas well
 3 Watertight sewer lines 6 Seepage pit 9 Feedyard 12 Fertilizer storage 16 Other (specify below)
 13 Insecticide storage
 Direction from well? north east How many feet? 100

FROM	TO	LITHOLOGIC LOG	FROM	TO	PLUGGING INTERVALS
0	3	Top soil	131	140	Light blue gray shale
3	33	Brown & white clay	140	145	Light gray, yellow brown sandy clay & streaks of sand rock
33	36	Brown sandy clay & rock			
36	54	Sand rock	145	180	Sand rock
54	63	Red & gray fire clay			
63	67	Light gray shale			
67	70	Sand rock			
70	86	Blue gray shale			
86	90	Red & gray fire clay			
90	110	Light gray shale			
110	112	Hard Iron Pyrite & lime stone			
112	121	Hard sand rock			
121	123	Hard Iron pyrite & lime stone			
123	128	Sandy light gray shale			
128	131	Sandy blue gray shale & sand rock			

7 CONTRACTOR'S OR LANDOWNER'S CERTIFICATION: This water well was (1) constructed, (2) reconstructed, or (3) plugged under my jurisdiction and was completed on (mo/day/year) ... 8-3-98 ... and this record is true to the best of my knowledge and belief. Kansas Water Well Contractor's License No. ... 134 ... This Water Well Record was completed on (mo/day/yr) ... 8-19-98 ... under the business name of Rosencrantz-Bemis by (signature) Freddie Dodson

OFFICE USE ONLY
T
R
EW
SEC
1/4
1/4
1/4