

WATER WELL RECORD

Form WWC-5


Division of Water Resources App. No.

1 LOCATION OF WATER WELL: County: Rice, Fraction 1/4 NW 1/4 NE 1/4 SE 1/4, Section Number 10, Township No. T 18 S, Range Number R 10

Street/Rural Address of Well Location; if unknown, distance & direction from nearest town or intersection: If at owner's address, check here [ ]. 1/2 South, 1/2 West of Bushton

Global Positioning System (GPS) information: Latitude: ..., Longitude: ..., Elevation: ..., Datum: [ ] WGS 84, [ ] NAD 83, [ ] NAD 27, Collection Method: [ ] GPS unit, [ ] Digital Map/Photo, [ ] Topographic Map, [ ] Land Survey

2 WATER WELL OWNER: American Warrior, RR#, Street Address, Box #: PO Box 399, City, State, ZIP Code: Garden City, KS 67846

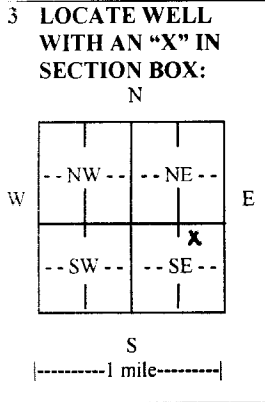

3 LOCATE WELL WITH AN 'X' IN SECTION BOX: 4 DEPTH OF COMPLETED WELL 170 ft. Depth(s) Groundwater Encountered (1) 66 ft. (2) ... (3) ... WELL'S STATIC WATER LEVEL 66 ft. below land surface measured on mo/day/yr 9-4-14

5 TYPE OF CASING USED: [ ] Steel [x] PVC [ ] Other, CASING JOINTS: [x] Glued [ ] Clamped [ ] Welded [ ] Threaded, Casing diameter 5 in. to 170 ft., Casing height above land surface 18 in., Weight SDR-26 lbs./ft., TYPE OF SCREEN OR PERFORATION MATERIAL: [ ] Steel [ ] Stainless Steel [x] PVC [ ] Other (Specify) ...

6 GROUT MATERIAL: [ ] Neat cement [ ] Cement grout [x] Bentonite [ ] Other, Grout Intervals: From ... ft. to ... ft., From 20 ft. to 0 ft., From ... ft. to ... ft., What is the nearest source of possible contamination: [ ] Septic tank [ ] Lateral lines [ ] Pit privy [ ] Livestock pens [ ] Insecticide storage [x] Other (specify below) ...

Table with columns: FROM, TO, LITHOLOGIC LOG, FROM, TO, LITHO. LOG (cont.) or PLUGGING INTERVALS. Rows include: 0-3 Top soil, 3-17 Brown clay, 17-47 Fire clay, 47-56 Sandstone, 56-89 Fire clay, 89-124 Gray shale w/ streaks of limestone & iron pyrite, 124-170 Sandstone, shale, & iron pyrite

7 CONTRACTOR'S OR LANDOWNER'S CERTIFICATION: This water well was [x] constructed, [ ] reconstructed, or [ ] plugged under my jurisdiction and was completed on (mo/day/year) 9-4-14 and this record is true to the best of my knowledge and belief. Kansas Water Well Contractor's License No. 134 This Water Well Record was completed on (mo/day/year) 9-18-14 under the business name of Rosencrantz-Bemis Ent Inc by (signature) Don Alief

INSTRUCTIONS: Use typewriter or ball point pen. PLEASE PRESS FIRMLY and PRINT clearly. Please fill in blanks and check the correct answers. Send three copies (white, blue, pink) to Kansas Department of Health and Environment, Bureau of Water, Geology Section, 1000 SW Jackson St., Suite 420, Topeka, Kansas 66612-1367. Telephone 785-296-5524. Send one copy to WATER WELL OWNER and retain one for your records. Include fee of \$5.00 for each constructed well. Visit us at http://www.kdheks.gov/waterwell/index.html.