


1 LOCATION OF WATER WELL:	Fraction	Section Number	Township Number	Range Number
County: Rice	NE 1/4 SW 1/4 NE 1/4	2	T 18 S	R 10 W

Distance and direction from nearest town or city street address of well if located within city?
 Approximately 140' north of the dead end of N. 2nd Street, Bushton, KS

2 WATER WELL OWNER: Bushton, City of
 City Hall
 RR#, St. Address, Box #: Box 194
 City, State, ZIP Code: Bushton, KS 67427
 Board of Agriculture, Division of Water Resources
 Application Number: RC 005 **vested Right**

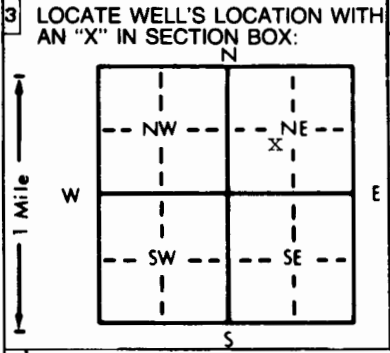

4 DEPTH OF COMPLETED WELL: 125 ft. ELEVATION: unknown

Depth(s) Groundwater Encountered 1. ft. 2. ft. 3. ft.

WELL'S STATIC WATER LEVEL: 39.45 ft. below land surface measured on mo/day/yr 1-27-94

Pump test data: Well water was not ch'd. ft. after hours pumping gpm

Est. Yield unknown gpm: Well water was ft. after hours pumping gpm

Bore Hole Diameter: 20 in. to 123 ft., and in. to ft.

WELL WATER TO BE USED AS:

5 Public water supply	8 Air conditioning	11 Injection well
1 Domestic	3 Feedlot	6 Oil field water supply
2 Irrigation	4 Industrial	7 Lawn and garden only
		9 Dewatering
		10 Monitoring well
		12 Other (Specify below)

Was a chemical/bacteriological sample submitted to Department? Yes. No. X.; If yes, mo/day/yr sample was submitted

Water Well Disinfected? Yes X No

5 TYPE OF BLANK CASING USED:

1 Steel	3 RMP (SR)	6 Asbestos-Cement	9 Other (specify below)
2 PVC	4 ABS	7 Fiberglass	

Blank casing diameter 8 in. to 93 ft., Dia in. to ft., Dia in. to ft.

Casing height above land surface 24 in., weight 6,86 lbs./ft. Wall thickness or gauge No. 411

TYPE OF SCREEN OR PERFORATION MATERIAL:

1 Steel	3 Stainless steel	5 Fiberglass	8 RMP (SR)	11 Other (specify)
2 Brass	4 Galvanized steel	6 Concrete tile	9 ABS	12 None used (open hole)

SCREEN OR PERFORATION OPENINGS ARE:

1 Continuous slot	3 Mill slot	6 Wire wrapped	9 Drilled holes
2 Louvered shutter	4 Key punched	7 Torch cut	10 Other (specify)
		5 Gauzed wrapped	8 Saw cut
			11 None (open hole)

SCREEN-PERFORATED INTERVALS: From 93 ft. to 123 ft., From ft. to ft.

GRAVEL PACK INTERVALS: From 88 ft. to 123 ft., From ft. to ft.

6 GROUT MATERIAL: 1 Neat cement 2 Cement grout 75% Sand and 25% Bentonite Holeplug 3 Bentonite 4 Other Bentonite Holeplug

Grout Intervals: From 0 ft. to 25 ft., From 25 ft. to 83 ft., From 83 ft. to 88 ft.

What is the nearest source of possible contamination:

1 Septic tank	4 Lateral lines	7 Pit privy	10 Livestock pens	14 Abandoned water well
2 Sewer lines	5 Cess pool	8 Sewage lagoon	11 Fuel storage	15 Oil well/Gas well
3 Watertight sewer lines	6 Seepage pit	9 Feedyard	12 Fertilizer storage	16 Other (specify below)
			13 Insecticide storage	None known

Direction from well? How many feet?

FROM	TO	LITHOLOGIC LOG	FROM	TO	PLUGGING INTERVALS
0	4	Topsoil			
4	40	Clay, brown			
40	54	Clay, red and gray			
54	63	Sandstone			
63	70	Clay, red, gray			
70	123	Sandstone			
123		Clay, red			

7 CONTRACTOR'S OR LANDOWNER'S CERTIFICATION: This water well was (1) constructed, (2) reconstructed, or (3) plugged under my jurisdiction and was completed on (mo/day/year) 1-27-94 and this record is true to the best of my knowledge and belief. Kansas Water Well Contractor's License No. 185. This Water Well Record was completed on (mo/day/yr) 2-22-94 under the business name of Clarke Well & Equipment, Inc. by (signature) *Clarke Well & Equipment*