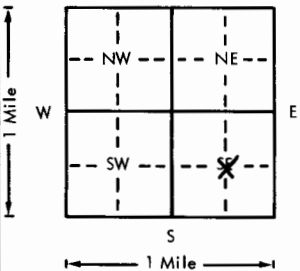


USE TYPEWRITER OR BALL POINT PEN-PRESS FIRMLY, PRINT CLEARLY.

WATER WELL RECORD
KSA 82a-1201-1215

Kansas Department of Health and Environment
Division of Environment (Water well Contractors)
Topeka, Kansas 66620

Barber?

1. Location of well: County <u>Rice</u> Fraction <u>1/4 C 1/4 SE 1/4</u> Section number <u>7</u> Township number <u>T 18 S R 10</u> Range number <u>10</u> E/W	
2. Distance and direction from nearest town or city: <u>4 1/2 mi. W. 1 mi. S. from Blushton, KS.</u> Street address of well location if in city: <u>Blushton, KS.</u>	
3. Owner of well: <u>BEN Drilling Co.</u> R.R. or street: <u>Municipal Airport</u> City, state, zip code: <u>Independence, KS 67301</u>	
4. Locate with "X" in section below: Sketch map: 	
5. Type and color of material	
6. Bore hole dia. <u>11</u> in. Completion date <u>8-18-77</u> Well depth <u>205</u> ft.	
7. <input type="checkbox"/> Cable tool <input checked="" type="checkbox"/> Rotary <input type="checkbox"/> Driven <input type="checkbox"/> Dug <input type="checkbox"/> Hollow rod <input type="checkbox"/> Jetted <input type="checkbox"/> Bored <input type="checkbox"/> Reverse rotary	
8. Use: <input type="checkbox"/> Domestic <input type="checkbox"/> Public supply <input checked="" type="checkbox"/> Industry <input type="checkbox"/> Irrigation <input type="checkbox"/> Air conditioning <input type="checkbox"/> Stock <input type="checkbox"/> Lawn <input type="checkbox"/> Oil field water <input type="checkbox"/> Other	
9. Casing: Material <u>PVC</u> Height: Above or below Threading: <input type="checkbox"/> Threaded <input type="checkbox"/> Welded Surface <u>18</u> in. RMP: <input type="checkbox"/> PVC <input checked="" type="checkbox"/> Weight <u> </u> lbs./ft. Dia. <u>4 1/2</u> in. to <u>205</u> ft. depth Wall Thickness: inches or Dia. <u> </u> in. to <u> </u> ft. depth gage No. <u>1237</u>	
10. Screen: Manufacturer's name <u>Certainfeed</u> Type <u>PVC</u> Dia. <u> </u> Slot <u>1/16</u> Length <u>40</u> Set between <u>11.5</u> ft. and <u>205</u> ft. Gravel pack? <input checked="" type="checkbox"/> Size range of material <u>2 3/4 3/8</u>	
11. Static water level: <u>26</u> ft. below land surface Date <u>8-18-77</u> mo./day/yr.	
12. Pumping level below land surfaces: <u>20</u> ft. after <u>1</u> hrs. pumping <u>40</u> g.p.m. <u> </u> ft. after <u> </u> hrs. pumping <u> </u> g.p.m. Estimated maximum yield <u>100</u> g.p.m.	
13. Water sample submitted: <input checked="" type="checkbox"/> Yes <input type="checkbox"/> No Date <u>8-18-77</u> mo./day/yr.	
14. Well head completion: <input type="checkbox"/> Pitless adapter <u> </u> inches above grade	
15. Well grouted? <input checked="" type="checkbox"/> With: <input checked="" type="checkbox"/> Neat cement <input type="checkbox"/> Bentonite <input type="checkbox"/> Concrete Depth: From <u>0</u> ft. to <u>10</u> ft.	
16. Nearest source of possible contamination: <u>200</u> ft. Direction <u>SE</u> Type <u>oil well</u> Well disinfected upon completion? <input checked="" type="checkbox"/> Yes <input type="checkbox"/> No	
17. Pump: Not installed Manufacturer's name <u>Red Jacket</u> Model number <u> </u> HP <u>15</u> Volts <u>230</u> Length of drop pipe <u>168</u> ft. capacity <u>100</u> g.p.m. Type: <input checked="" type="checkbox"/> Submersible <input type="checkbox"/> Turbine <input type="checkbox"/> Jet <input type="checkbox"/> Reciprocating <input type="checkbox"/> Centrifugal <input type="checkbox"/> Other	
(Use a second sheet if needed)	
18. Elevation: Topography: <input type="checkbox"/> Hill <input type="checkbox"/> Slope <input checked="" type="checkbox"/> Upland <input type="checkbox"/> Valley	19. Remarks:
20. Water well contractor's certification: This well was drilled under my jurisdiction and this report is true to the best of my knowledge and belief. <u>Robert Benis</u> 134 Business name License No. Address <u>Great Bend, KS 67530</u> Signed <u>Robert Benis</u> Date <u>8-22-77</u> Authorized representative	

T 18 S R 10 E W 7 SE 1/4 1/4 1/4 1/4