

USE TYPEWRITER OR BALL POINT PEN-PRESS FIRMLY, PRINT CLEARLY.


T R EW sec 1/4 1/4 1/4 No.

WATER WELL RECORD
KSA 82a-1201-1215

Kansas State Dept. Of Health
(Water Well Contractors)
Forbes-Bldg. 740
Topeka, Kansas 66620

1 Location of well:	County Rice	Township name	Fraction NE/NE/NE	Section number 11	Town number 18	Range number 10
---------------------	-----------------------	---------------	-----------------------------	-----------------------------	--------------------------	---------------------------

Distance and direction from nearest town or city: 1/2 E - 1/2 S of Bushton, Kansas Street address of well location if in city:	3 Owner of well: Address: H-30 Drilling Co. 200 North Main St. Wichita, Ks.
---	--

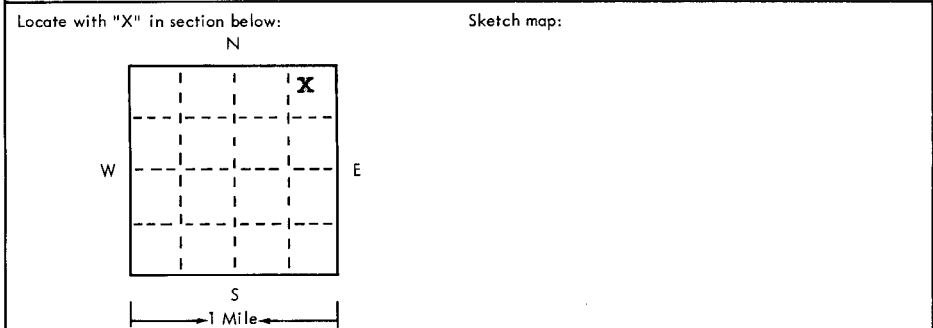

4 Well depth: **180** ft. Date of completion **2-21-75**
Well diameter **7 7/8**

5 Cable tool Rotary Driven Dug
 Hollow rod Jetted Bored Reverse rotary

6 Use: Domestic Public supply Industry
 Irrigation Air conditioning Commercial
 Test well **Oil Field Water Supply**

7 Casing: Material **pvc** Weight: **above/below**
Threaded Welded Surface **14** in.
Diam. Weight **160** lbs./ft.
4 in. to **140** depth Drive shoe? Yes No
___ in. to ___ ft. depth

2 Type and color of material	From	To
Top soil	0	3
Clay	3	35
Sand	35	40
Clay	40	64
Sand	64	70
Sand rock	70	77
Shale	77	85
Fire clay	85	92
Shale	92	120
Sand rock	120	180
(use a second sheet if needed)		

8 Screen: Manufacturer **R & E**
Type **pvc** Dia. **4**
Slot gauze **1/16** Length **40**
Set between **140** ft. and **180** ft.
Fittings: **3/4-3/8-1/16**
Gravel pack Yes No Size range of material **CM-3**

9 Static water level:
55 ft. below land surface Date **2-21-75**

10 Pumping level below land surfaces: **NA**
___ ft. after ___ hrs. pumping ___ g.p.m.
___ ft. after ___ hrs. pumping ___ g.p.m.
Estimated maximum yield ___ g.p.m.

11 Water sample submitted:
 Yes No Date ___

12 Well head completion:
 Pitless adapter **14** inches above grade

13 Well grouted? Yes No
 Neat cement Bentonite ___
Depth: From ___ ft. to ___ ft.

14 Nearest source of possible contamination:
ft. **96** Direction **SW** Type **Oil well**
Well disinfected upon completion? Yes No

15 Pump: Not installed
Manufacturer's name _____
Model number _____ HP _____ Volts _____
Length of drop pipe _____ ft. capacity _____ g.m.p.
Type:
 Submersible Turbine
 Jet Reciprocating
 Centrifugal Other

16 Remarks: elevation

Topography:
 Hill
 Slope
 Upland
 Valley

well will be pulled & plugged at later date.

17 Water well contractor's certification:
This well was drilled under my jurisdiction and this report is true to the best of my knowledge and belief.
Rosencrantz-Bemis 134
Business name License No.
Address **Great Bend, Ks.**
Signed **Fredia Dodson** Date **2-24-75**
Authorized representative