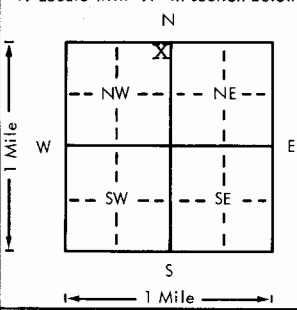


USE TYPEWRITER OR BALL POINT PEN-PRESS FIRMLY, PRINT CLEARLY.

WATER WELL RECORD  
KSA 82a-1201-1215

Kansas Department of Health and Environment-Division of Environment  
(Water well Contractors)  
Topeka, Kansas 66620

1. Location of well:	County <b>Rice</b>	Fraction <b>ne 1/4 ne 1/4 nw 1/4</b>	Section number <b>12</b>	Township number <b>T 18 S</b>	Range number <b>R 10W E/W</b>
2. Distance and direction from nearest town or city: <b>1e</b> Street address of well location if in city: <b>Bushton Ks.</b>			3. Owner of well: <b>David Hoelscher</b> R.R. or street: <b>R1 Bushton, Ks.</b> City, state, zip code:		
4. Locate with "X" in section below: 			Sketch map:		
5. Type and color of material			From	To	6. Bore hole dia. <u>8</u> in. Completion date <u>11-11-77</u> Well depth <u>210</u> ft.
					7. <input type="checkbox"/> Cable tool <input checked="" type="checkbox"/> Rotary <input type="checkbox"/> Driven <input type="checkbox"/> Dug <input type="checkbox"/> Hollow rod <input type="checkbox"/> Jetted <input type="checkbox"/> Bored <input type="checkbox"/> Reverse rotary
					8. Use: <input checked="" type="checkbox"/> Domestic <input type="checkbox"/> Public supply <input type="checkbox"/> Industry <input type="checkbox"/> Irrigation <input type="checkbox"/> Air conditioning <input type="checkbox"/> Stock <input type="checkbox"/> Lawn <input type="checkbox"/> Oil field water <input type="checkbox"/> Other
					9. Casing: Material _____ Height: Above <del>63</del> <u>12</u> ft. Threaded _____ Welded _____ Surface <u>12</u> in. RMP _____ PVC <input checked="" type="checkbox"/> Weight _____ lbs./ft. Dia. <u>5</u> in. to <u>210</u> ft. depth Wall Thickness: inches or Dia. _____ in. to _____ ft. depth gage No. <u>Sch 40</u>
					10. Screen: Manufacturer's name <u>Jetstream</u> Type <u>pvc</u> Dia. <u>5"</u> Slot/gauze <u>1/32"</u> Length <u>30</u> Set between <u>180</u> ft. and <u>210</u> ft. _____ ft. and _____ ft. Gravel pack? <input checked="" type="checkbox"/> Size range of material <u>1/8-3/4"</u>
					11. Static water level: _____ mo./day/yr. <u>40</u> ft. below land surface Date <u>11-11-77</u>
					12. Pumping level below land surfaces: _____ ft. after _____ hrs. pumping _____ g.p.m. _____ ft. after _____ hrs. pumping _____ g.p.m. Estimated maximum yield <u>50</u> g.p.m.
		13. Water sample submitted: _____ mo./day/yr. <input type="checkbox"/> Yes <input checked="" type="checkbox"/> No Date _____			
		14. Well head completion: <input type="checkbox"/> Pitless adapter <u>12</u> Inches above grade			
		15. Well grouted? <input checked="" type="checkbox"/> With: <input checked="" type="checkbox"/> Neat cement <input type="checkbox"/> Bentonite <input type="checkbox"/> Concrete Depth: From <u>0</u> ft. to <u>10</u> ft.			
		16. Nearest source of possible contamination: ft. <u>75</u> Direction <u>e</u> Type <u>sewer</u> Well disinfected upon completion? <input checked="" type="checkbox"/> Yes <input type="checkbox"/> No			
		17. Pump: <input checked="" type="checkbox"/> Not installed Manufacturer's name _____ Model number _____ HP _____ Volts _____ Length of drop pipe _____ ft. capacity _____ g.p.m. Type: <input type="checkbox"/> Submersible <input type="checkbox"/> Turbine <input type="checkbox"/> Jet <input type="checkbox"/> Reciprocating <input type="checkbox"/> Centrifugal <input type="checkbox"/> Other			
(Use a second sheet if needed)					
18. Elevation:	19. Remarks:		20. Water well contractor's certification: This well was drilled under my jurisdiction and this report is true to the best of my knowledge and belief. <b>Kellys Waterwell Ser 186</b> Business name _____ License No. _____ Address <u>R2 Great Bend, Ks.</u> Signed <u>Kelly Paice</u> Date <u>8-13</u> Authorized representative		
Topography: <input type="checkbox"/> Hill <input type="checkbox"/> Slope <input checked="" type="checkbox"/> Upland <input type="checkbox"/> Valley					

T  
R  
E  
S  
E  
C  
18  
10  
12  
NE  
NE  
NW  
1/4  
1/4  
1/4