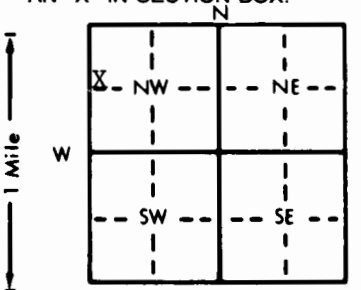


1 LOCATION OF WATER WELL: Fraction SW 1/4 NW 1/4 NW 1/4 Section Number 19 Township Number T 18 S Range Number R 10 **R/W**
 County: Rice

Distance and direction from nearest town or city street address of well if located within city?
 Approx. 4 1/2 miles West and 3 1/2 miles South of Bushton

2 WATER WELL OWNER: Virgil Zink
 RR#, St. Address, Box # : Rt. #1 Board of Agriculture, Division of Water Resources
 City, State, ZIP Code : Claflin, Kansas 67525 Application Number: N/A

3 LOCATE WELL'S LOCATION WITH AN "X" IN SECTION BOX:

 4 DEPTH OF COMPLETED WELL... 54 ft. ELEVATION: unknown
 Depth(s) Groundwater Encountered 1. 22 ft. 2. ft. 3. ft.
 WELL'S STATIC WATER LEVEL... 22 ft. below land surface measured on mo/day/yr 8-05-88
 Pump test data: Well water was not ch'd ft. after hours pumping gpm
 Est. Yield unknown gpm: Well water was ft. after hours pumping gpm
 Bore Hole Diameter. 11 in. to 52 ft., and in. to ft.
 WELL WATER TO BE USED AS: 5 Public water supply 8 Air conditioning 11 Injection well
 1 Domestic 3 Feedlot 6 Oil field water supply 9 Dewatering 12 Other (Specify below)
 2 Irrigation 4 Industrial 7 Lawn and garden only 10 Observation well
 Was a chemical/bacteriological sample submitted to Department? Yes No **X**; If yes, mo/day/yr sample was submitted
 Water Well Disinfected? Yes **X** No

5 TYPE OF BLANK CASING USED:
 1 Steel 3 RMP (SR) 5 Wrought iron 8 Concrete tile CASING JOINTS: Glued Clamped
 2 PVC 4 ABS 6 Asbestos-Cement 9 Other (specify below) Welded
 7 Fiberglass Threaded
 Blank casing diameter... **X** 5 in. to 38 ft., Dia in. to ft., Dia in. to ft.
 Casing height above land surface... 24 in., weight 2.277 lbs./ft. Wall thickness or gauge No. 214
 TYPE OF SCREEN OR PERFORATION MATERIAL:
 1 Steel 3 Stainless steel 5 Fiberglass 7 PVC 10 Asbestos-cement
 2 Brass 4 Galvanized steel 6 Concrete tile 8 RMP (SR) 11 Other (specify)
 9 ABS 12 None used (open hole)
 SCREEN OR PERFORATION OPENINGS ARE:
 1 Continuous slot 3 Mill slot 5 Gauzed wrapped 8 Saw cut 11 None (open hole)
 2 Louvered shutter 4 Key punched 6 Wire wrapped 9 Drilled holes
 7 Torch cut 10 Other (specify)
 SCREEN-PERFORATED INTERVALS: From 38 ft. to 52 ft., From ft. to ft.
 GRAVEL PACK INTERVALS: From 25 ft. to 52 ft., From ft. to ft.
 Annular fill From 21 ft. to 25 ft., From ft. to ft.

6 GROUT MATERIAL: A 1 Neat cement 2 Cement grout B 3 Bentonite 4 Other
 Grout Intervals: From A 5 ft. to 20 ft., From B 20 ft. to 21 ft., From ft. to ft.
 What is the nearest source of possible contamination:
 1 Septic tank 4 Lateral lines 7 Pit privy 10 Livestock pens 14 Abandoned water well
 2 Sewer lines 5 Cess pool 8 Sewage lagoon 11 Fuel storage 15 Oil well/Gas well
 3 Watertight sewer lines 6 Seepage pit 9 Feedyard 12 Fertilizer storage 16 Other (specify below)
 13 Insecticide storage
 Direction from well? South **X** How many feet? 100

FROM	TO	LITHOLOGIC LOG	FROM	TO	LITHOLOGIC LOG
0	30	Topsoil and gray and tan clay			
30	40	tan clay with broken limestone, some soft water clay			
40	42	real soft tan clay			
42	52	soft tan clay, water clay			

7 CONTRACTOR'S OR LANDOWNER'S CERTIFICATION: This water well was (1) constructed, (2) reconstructed, or (3) plugged under my jurisdiction and was completed on (mo/day/year) 8-05-88 and this record is true to the best of my knowledge and belief. Kansas Water Well Contractor's License No. 185 This Water Well Record was completed on (mo/day/yr) 8-26-88 under the business name of Clarke Well & Equipment Co., Inc. by (signature) *Virgil Zink*

INSTRUCTIONS: Use typewriter or ball point pen. PLEASE PRESS FIRMLY and PRINT clearly. Please fill in blanks, underline or circle the correct answers. Send top three copies to Kansas Department of Health and Environment, Bureau of Water Protection, Topeka, Kansas 66620-7320, Telephone: 913-862-9360. Send one to WATER WELL OWNER and retain one for your records.

OFFICE USE ONLY
T
R
EW
SEC.