


1 LOCATION OF WATER WELL: County: Rice Fraction: NE 1/4 SW 1/4 SE 1/4 Section Number: 32 Township Number: T 18 S Range Number: R 10 **EW**

Distance and direction from nearest town or city street address of well if located within city?
Approximately 5 miles south and 2 1/2 miles west of Bushton, KS

2 WATER WELL OWNER: Mike Ringwald
 RR#, St. Address, Box # : _____ Board of Agriculture, Division of Water Resources
 City, State, ZIP Code : Bushton, KS 67427 Application Number: N/A

3 LOCATE WELL'S LOCATION WITH AN "X" IN SECTION BOX:

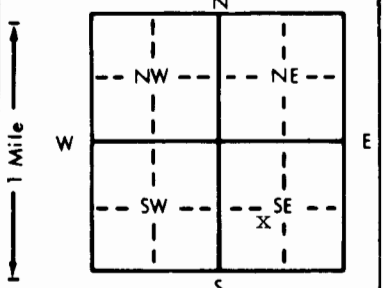

4 DEPTH OF COMPLETED WELL: 54 ft. ELEVATION: unknown

Depth(s) Groundwater Encountered 1. _____ ft. 2. _____ ft. 3. _____ ft.
 WELL'S STATIC WATER LEVEL: 10 ft. below land surface measured on mo/day/yr
 Pump test data: Well water was not ch'd. ft. after _____ hours pumping _____ gpm
 Est. Yield unknown gpm: Well water was _____ ft. after _____ hours pumping _____ gpm
 Bore Hole Diameter: 9 in. to 54 ft., and _____ in. to _____ ft.
 WELL WATER TO BE USED AS:
 1 Domestic 3 Feedlot 6 Oil field water supply 9 Dewatering 12 Other (Specify below)
 2 Irrigation 4 Industrial 7 Lawn and garden only 10 Monitoring well Stock
 Was a chemical/bacteriological sample submitted to Department? Yes _____ No x _____; If yes, mo/day/yr sample was submitted _____
 Water Well Disinfected? Yes _____ No x _____

5 TYPE OF BLANK CASING USED:
 1 Steel 3 RMP (SR) 5 Wrought iron 8 Concrete tile CASING JOINTS: Glued x _____ Clamped _____
 2 PVC 4 ABS 6 Asbestos-Cement 9 Other (specify below) Welded _____
 _____ _____ 7 Fiberglass _____ Threaded _____

Blank casing diameter: 5 in. to 14 ft., Dia 5 in. to 32 ft., Dia _____ in. to _____ ft.
 Casing height above land surface: _____ in., weight _____ lbs./ft. Wall thickness or gauge No. _____

TYPE OF SCREEN OR PERFORATION MATERIAL:
 1 Steel 3 Stainless steel 5 Fiberglass 7 PVC 10 Asbestos-cement
 2 Brass 4 Galvanized steel 6 Concrete tile 8 RMP (SR) 11 Other (specify) _____
 _____ _____ _____ 9 ABS 12 None used (open hole)

SCREEN OR PERFORATION OPENINGS ARE:
 1 Continuous slot 3 Mill slot 5 Gauzed wrapped 8 Saw cut 11 None (open hole)
 2 Louvered shutter 4 Key punched 6 Wire wrapped 9 Drilled holes
 _____ _____ _____ 10 Other (specify) _____

SCREEN-PERFORATED INTERVALS: From 14 ft. to 22 ft., From _____ ft. to _____ ft.
 From 22 ft. to 32 ft., From _____ ft. to _____ ft.
 GRAVEL PACK INTERVALS: From 12 ft. to 52 ft., From _____ ft. to _____ ft.
 From _____ ft. to _____ ft., From _____ ft. to _____ ft.

6 GROUT MATERIAL: 1 Neat cement 2 Cement grout 3 Bentonite 4 Other Bentonite hole plug
 Grout Intervals: From 5 ft. to 10 ft., From _____ ft. to _____ ft., From 10 ft. to 12 ft.

What is the nearest source of possible contamination:
 1 Septic tank 4 Lateral lines 7 Pit privy 10 Livestock pens 14 Abandoned water well
 2 Sewer lines 5 Cess pool 8 Sewage lagoon 11 Fuel storage 15 Oil well/Gas well
 3 Watertight sewer lines 6 Seepage pit 9 Feedyard 12 Fertilizer storage 16 Other (specify below)
 _____ _____ _____ 13 Insecticide storage none known

Direction from well? _____ How many feet? _____

FROM	TO	LITHOLOGIC LOG	FROM	TO	PLUGGING INTERVALS
0	4	Topsoil			
4	14	Clay, brown			
14	22	Streaks of very fine sand and Gravel and fine sand and streaks of clay, brown, sandy, soft			
22	30	Clay, brown			
30	52	Clay, brown, real soft sandy, with streaks of fine sand			
52		Clay, brown			

7 CONTRACTOR'S OR LANDOWNER'S CERTIFICATION: This water well was (1) constructed, (2) reconstructed, or (3) plugged under my jurisdiction and was completed on (mo/day/year) 8-21-89 and this record is true to the best of my knowledge and belief. Kansas Water Well Contractor's License No. 185 This Water Well Record was completed on (mo/day/yr) 8-24-89 under the business name of Clarke Well & Equipment, Inc. by (signature) [Signature]

OFFICE USE ONLY
T
R
EW
SEC
1/4
1/4
1/4