


1 LOCATION OF WATER WELL: Fraction SW 1/4 SW 1/4 SE 1/4 Section Number 8 Township Number T 18 S Range Number R 11 **EW**
 County: Barton

Distance and direction from nearest town or city street address of well if located within city?
 Claflin, Ks. 1 west, 1 3/4 south

2 WATER WELL OWNER: Joseph Jordan
 RR#, St. Address, Box #: 411 Shady Lane Board of Agriculture, Division of Water Resources
 City, State, ZIP Code:)'Fallon, MO. 63366 Application Number: BTWW 0544

3 LOCATE WELL'S LOCATION WITH AN "X" IN SECTION BOX:

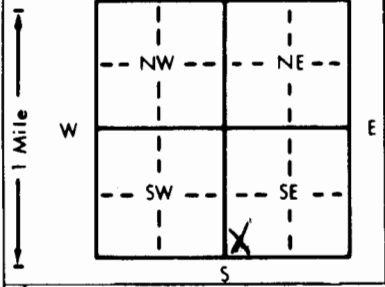

4 DEPTH OF COMPLETED WELL: 105 ft. ELEVATION:
 Depth(s) Groundwater Encountered 1. ft. 2. ft. 3. ft.
 WELL'S STATIC WATER LEVEL . . . 20 . . . ft. below land surface measured on mo/day/yr . . . 12-21-96 . . .
 Pump test data: Well water was ft. after hours pumping gpm
 Est. Yield . . . na . . . gpm: Well water was ft. after hours pumping gpm
 Bore Hole Diameter . . . 9 7/8 . . . to . . . 105 . . . ft., and in. to ft.
 WELL WATER TO BE USED AS: 5 Public water supply 8 Air conditioning 11 Injection well
 1 Domestic 3 Feedlot 6 Oil field water supply 9 Dewatering 12 Other (Specify below)
 2 Irrigation 4 Industrial 7 Lawn and garden only 10 Monitoring well
 Was a chemical/bacteriological sample submitted to Department? Yes No . . . X; If yes, mo/day/yr sample was sub-
 mitted Water Well Disinfected? Yes hth No

5 TYPE OF BLANK CASING USED: 5 Wrought iron 8 Concrete tile CASING JOINTS: Glued . X . . . Clamped
 1 Steel 3 RMP (SR) 6 Asbestos-Cement 9 Other (specify below) Welded
 2 PVC 4 ABS 7 Fiberglass Threaded
 Blank casing diameter . . . 5 . . . in. to . . . 65 . . . ft., Dia in. to ft., Dia in. to ft.
 Casing height above land surface . . . 18" . . . in., weight . . . SDR 26 lbs./ft. Wall thickness or gauge No.
 TYPE OF SCREEN OR PERFORATION MATERIAL: 7 PVC 10 Asbestos-cement
 1 Steel 3 Stainless steel 5 Fiberglass 8 RMP (SR) 11 Other (specify)
 2 Brass 4 Galvanized steel 6 Concrete tile 9 ABS 12 None used (open hole)
 SCREEN OR PERFORATION OPENINGS ARE: 5 Gauzed wrapped 8 Saw cut 11 None (open hole)
 1 Continuous slot 3 Mill slot 6 Wire wrapped 9 Drilled holes
 2 Louvered shutter 4 Key punched 7 Torch cut 10 Other (specify)
 SCREEN-PERFORATED INTERVALS: From . . . 105 . . . ft. to . . . 65 . . . ft., From ft. to ft.
 From ft. to ft., From ft. to ft.
 GRAVEL PACK INTERVALS: From . . . 105 . . . ft. to . . . 50 . . . ft., From . . . 45 . . . ft. to . . . 20 . . . ft.
 From ft. to ft., From ft. to ft.

6 GROUT MATERIAL: 1 Neat cement 2 Cement grout 3 Bentonite 4 Other hole plug
 Grout Intervals: From . . . 50 . . . ft. to . . . 45 . . . ft., From . . . 20 . . . ft. to . . . 0 . . . ft., From ft. to ft.
 What is the nearest source of possible contamination:
 1 Septic tank 4 Lateral lines 7 Pit privy 10 Livestock pens 14 Abandoned water well
 2 Sewer lines 5 Cess pool 8 Sewage lagoon 11 Fuel storage 15 Oil well/Gas well
 3 Watertight sewer lines 6 Seepage pit 9 Feedyard 12 Fertilizer storage 16 Other (specify below)
 13 Insecticide storage
 Direction from well? south west How many feet? 100'

FROM	TO	LITHOLOGIC LOG	FROM	TO	PLUGGING INTERVALS
0	3	Top soil			
3	11	Brown & gray clay			
11	30	Brown clay			
30	72	Brown & white clay			
72	85	Soft brown clay & white rock			
85	90	Broken sand rock, sandy brown clay and rock			
90	92	Brown clay			
92	93	Sand rock			
93	100	Blue, gray, yellow brown clay			
100	105	Sand rock and clay			

7 CONTRACTOR'S OR LANDOWNER'S CERTIFICATION: This water well was (1) constructed, (2) reconstructed, or (3) plugged under my jurisdiction and was completed on (mo/day/year) . . . 12-28-96 and this record is true to the best of my knowledge and belief. Kansas Water Well Contractor's License No. . . . 134 . . . This Water Well Record was completed on (mo/day/yr) . . . 1-16-97 under the business name of Rosencrantz-Bemis by (signature) Freddie Radson

INSTRUCTIONS: Use typewriter or ball point pen. PLEASE PRESS FIRMLY and PRINT clearly. Please fill in blanks, underline or circle the correct answers. Send top three copies to Kansas Department of Health and Environment, Bureau of Water, Topeka, Kansas 66620-0001. Telephone: 913-296-5545. Send one to WATER WELL OWNER and retain one for your records.