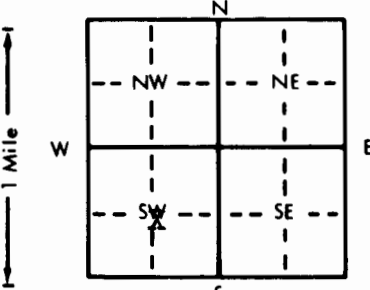


1 LOCATION OF WATER WELL: County: <u>Barton</u>	Fraction <u>C</u> $\frac{1}{4}$ <u>SW</u> $\frac{1}{4}$ $\frac{1}{4}$	Section Number <u>12</u>	Township Number <u>T 18</u> <u>S</u>	Range Number <u>R 11W</u> <u>E/W</u>
--	--	-----------------------------	---	---

Distance and direction from nearest town or city street address of well if located within city?

2 S, 3 E of Claflin, Kansas

2 WATER WELL OWNER: RR#, St. Address, Box # City, State, ZIP Code	<u>Glen Radenburg</u> <u>Route 1</u> <u>Claflin, Ks. 67525</u>	<u>Lobo Drilling Company</u> <u>Box 877</u> <u>Great Bend, Kansas 67530</u>	<u>Radenburg #1</u> Board of Agriculture, Division of Water Resources Application Number: <u>Unknown</u>
---	--	---	--

3 LOCATE WELL'S LOCATION WITH AN "X" IN SECTION BOX: 	4 DEPTH OF COMPLETED WELL... <u>200</u> ft. ELEVATION: <u>Unknown</u>
	Depth(s) Groundwater Encountered <u>165</u> ft. 2. <u>65</u> ft. 3. <u>8/7/85</u> ft. WELL'S STATIC WATER LEVEL <u>65</u> ft. below land surface measured on mo/day/yr Pump test data: Well water was <u>60</u> gpm: Well water was <u>8</u> in. to <u>200</u> ft. after <u>2.8</u> hours pumping <u>40</u> gpm Bore Hole Diameter <u>8</u> in. to <u>200</u> ft., and <u>2.8</u> in. to <u>40</u> ft. WELL WATER TO BE USED AS: 1 Domestic 3 Feedlot 6 <u>Oil field water supply</u> 9 Dewatering 12 Other (Specify below) 2 Irrigation 4 Industrial 7 Lawn and garden only 10 Observation well Was a chemical/bacteriological sample submitted to Department? Yes <u>No</u> ; If yes, mo/day/yr sample was submitted <u>No</u> Water Well Disinfected? Yes <u>No</u>

5 TYPE OF BLANK CASING USED: 1 Steel <u>2 PVC</u> Blank casing diameter <u>5</u> in. to <u>180</u> ft., Dia <u>12</u> in., weight <u>2.8</u> lbs./ft. Wall thickness or gauge No. <u>Sch. 40</u>	5 Wrought iron 6 Asbestos-Cement 7 Fiberglass	8 Concrete tile 9 Other (specify below)	CASING JOINTS: <u>Glued</u> Clamped <u>Welded</u> <u>Threaded</u>
TYPE OF SCREEN OR PERFORATION MATERIAL: 1 Steel 2 Brass SCREEN OR PERFORATION OPENINGS ARE: 1 Continuous slot 2 Louvered shutter	3 Stainless steel 4 Galvanized steel 3 Mill slot 4 Key punched	5 Fiberglass 6 Concrete tile 5 Gauzed wrapped 6 Wire wrapped 7 Torch cut	7 <u>PVC</u> 8 RMP (SR) 9 ABS 10 Asbestos-cement 11 Other (specify) 12 None used (open hole) 8 <u>Saw cut</u> 9 Drilled holes 10 Other (specify)
SCREEN-PERFORATED INTERVALS: From <u>180</u> ft. to <u>200</u> ft.	GRAVEL PACK INTERVALS: From <u>10</u> ft. to <u>200</u> ft.		

6 GROUT MATERIAL: Grout Intervals: From <u>0</u> ft. to <u>10</u> ft.	1 <u>Neat cement</u>	2 Cement grout	3 Bentonite	4 Other
What is the nearest source of possible contamination: 1 Septic tank 2 Sewer lines 3 Watertight sewer lines	4 Lateral lines 5 Cess pool 6 Seepage pit	7 Pit privy 8 Sewage lagoon 9 Feedyard	10 Livestock pens 11 Fuel storage 12 Fertilizer storage 13 Insecticide storage	14 Abandoned water well 15 <u>Oil well/Gas well</u> 16 Other (specify below)
Direction from well? <u>South</u>	How many feet? <u>60</u>			

FROM	TO	LITHOLOGIC LOG	FROM	TO	LITHOLOGIC LOG
0	125	Shale			
125	200	Sand rpck			

7 CONTRACTOR'S OR LANDOWNER'S CERTIFICATION: This water well was (1) <u>constructed</u> , (2) reconstructed, or (3) plugged under my jurisdiction and was completed on (mo/day/year) <u>8/7/85</u> and this record is true to the best of my knowledge and belief. Kansas Water Well Contractor's License No. <u>186</u> This Water Well Record was completed on (mo/day/yr) <u>9/21/85</u> under the business name of <u>Kelly's Water Well Service</u> by (signature) <u>[Signature]</u>
--

INSTRUCTIONS: Use typewriter or ball point pen, PLEASE PRESS FIRMLY and PRINT clearly. Please fill in blanks, underline or circle the correct answers. Send top three copies to Kansas Department of Health and Environment, Division of Environment, Environmental Geology Section, Topeka, KS 66620. Send one to WATER WELL OWNER and retain one for your records.