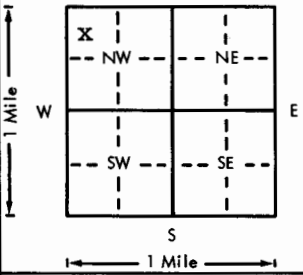


USE TYPEWRITER OR BALL POINT PEN-PRESS FIRMLY, PRINT CLEARLY.

WATER WELL RECORD
KSA 82a-1201-1215

Kansas Department of Health and Environment-Division of Environment (Water well Contractors) Topeka, Kansas 66620

1. Location of well:	County Barton	Fraction NW 1/4 NW 1/4 NW 1/4	Section number 22	Township number 18	Range number 11	E W
2. Distance and direction from nearest town or city: 3 miles south of Claflin, KS			3. Owner of well: Laura Oberle R.R. or street: 106 West 4th City, state, zip code: Ellinwood Kansas 67526			
4. Locate with "X" in section below: N  W E S 1 Mile			Sketch map:		6. Bore hole dia. 9 in. Completion date 10-13-77 Well depth 142 ft.	
5. Type and color of material			From	To	7. <input type="checkbox"/> Cable tool <input type="checkbox"/> Rotary <input type="checkbox"/> Driven <input type="checkbox"/> Dug <input type="checkbox"/> Hollow rod <input type="checkbox"/> Jetted <input type="checkbox"/> Bored <input checked="" type="checkbox"/> Reverse rotary	
Top Soil			0	3	8. Use: <input type="checkbox"/> Domestic <input type="checkbox"/> Public supply <input type="checkbox"/> Industry <input type="checkbox"/> Irrigation <input type="checkbox"/> Air conditioning <input checked="" type="checkbox"/> Stock <input type="checkbox"/> Lawn <input type="checkbox"/> Oil field water <input type="checkbox"/> Other	
Brown Clay and soil silt			3	30	9. Casing: Material Styrene Height Above or below Threaded <input type="checkbox"/> Welded <input checked="" type="checkbox"/> Surface 12 in. RMP 5 PVC 122 Weight 1.5 lbs./ft. Dia. 5 in. to 122 ft. depth Wall Thickness: inches or Dia. 5 in. to 122 ft. depth gage No. 200	
Brown Clay and broken lime stone			30	50	10. Screen: Manufacturer's name Jess & Lowell Styrene 200 Dia. 5" Slot/gauze 20' Length 20' Set between 122 ft. and 142 ft. Gravel pack? yes Size range of material 3/8-200 ft.	
Water clay and tight clay streaks			50	59	11. Static water level: NR 14 7/8 ft. below land surface Date 10/13/77 mo./day/yr.	
Brown clay and lime stone			59	70	12. Pumping level below land surfaces: NC ____ ft. after ____ hrs. pumping ____ g.p.m. ____ ft. after ____ hrs. pumping ____ g.p.m. Estimated maximum yield ____ g.p.m.	
Water clay			70	75	13. Water sample submitted: ____ mo./day/yr. <input type="checkbox"/> Yes <input checked="" type="checkbox"/> No Date ____	
Brown and grey clay			75	83	14. Well head completion: 12 <input type="checkbox"/> Pitless adapter 12 inches above grade	
Water clay and tight clay streaks			83	103	15. Well grouted? yes With: <input type="checkbox"/> Neat cement <input checked="" type="checkbox"/> Bentonite <input type="checkbox"/> Concrete Depth: From ____ ft. to 10 ft.	
Conglomerate			106	141	16. Nearest source of possible contamination: FIELD ft. ____ Direction ____ Type ____ Well disinfected upon completion? <input checked="" type="checkbox"/> Yes <input type="checkbox"/> No	
Dakota			141	142	17. Pump: <input checked="" type="checkbox"/> Not installed Manufacturer's name ____ Model number ____ HP ____ Volts ____ Length of drop pipe ____ ft. capacity ____ g.p.m. Type: <input type="checkbox"/> Submersible <input type="checkbox"/> Turbine <input type="checkbox"/> Jet <input type="checkbox"/> Reciprocating <input type="checkbox"/> Centrifugal <input type="checkbox"/> Other	
(Use a second sheet if needed)						
18. Elevation:	19. Remarks:		20. Water well contractor's certification: This well was drilled under my jurisdiction and this report is true to the best of my knowledge and belief. Clarke Well & Eq., Inc. 185 Business name Great Bend, KS License No. ____ Address 106 West 4th Signed Laura Oberle Date 10/13/77 Authorized representative			
Topography: <input type="checkbox"/> Hill <input type="checkbox"/> Slope <input type="checkbox"/> Upland <input type="checkbox"/> Valley						

BR →

18 11 W 22 Ellinwood
T
R
Sec
1/4 1/4 1/4