

USE TYPEWRITER OR BALL POINT PEN-PRESS FIRMLY, PRINT CLEARLY.


WATER WELL RECORD
KSA 82a-1201-1215

Kansas Department of Health and Environment-Division of Environment (Water well Contractors) Topeka, Kansas 66620

Allen

1. Location of well:	County Barton	Fraction SW 1/4 NE 1/4 NE 1/4	Section number 26	Township number T 18 S R 11 <i>NW</i>	Range number
----------------------	-------------------------	---	-----------------------------	--	--------------

2. Distance and direction from nearest town or city: 4 1/4 miles south and 1 3/4 miles east of Claflin, Ks.	3. Owner of well: David Wirth R.R. or street: R. R. 1 City, state, zip code: Hoisington, Kansas 67544
---	---

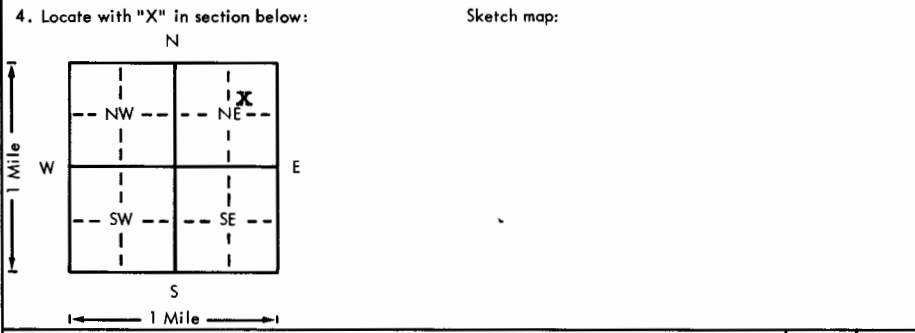

6. Bore hole dia. <u>12</u> in. Completion date _____ Well depth <u>105</u> ft. <u>9-25-79</u>
7. <input checked="" type="checkbox"/> Cable tool <input checked="" type="checkbox"/> Rotary <input type="checkbox"/> Driven <input type="checkbox"/> Dug <input type="checkbox"/> Hollow rod <input type="checkbox"/> Jetted <input type="checkbox"/> Bored <input type="checkbox"/> Reverse rotary
8. Use: <input checked="" type="checkbox"/> Domestic <input type="checkbox"/> Public supply <input type="checkbox"/> Industry <input type="checkbox"/> Irrigation <input type="checkbox"/> Air conditioning <input type="checkbox"/> Stock <input type="checkbox"/> Lawn <input type="checkbox"/> Oil field water <input type="checkbox"/> Other
9. Casing: Material <u>PVC</u> Height: Above or below _____ Threaded _____ Welded _____ Surface <u>12</u> in. RMP _____ PVC <input checked="" type="checkbox"/> Weight _____ lbs./ft. Di. <u>5 1/2</u> in. to <u>105</u> ft. depth Wall Thickness: inches or _____ Dia. _____ in. to _____ ft. depth gage No. <u>.258</u>

5. Type and color of material	From	To
top soil	0	3
brown clay and white rock	3	11
brown clay	11	37
light gray clay	37	53
light brown clay	53	78
gritty sandy brown soft clay	78	95
brown sandy clay some rock and sand rocks	95	103
fire clay	103	105
(Use a second sheet if needed)		

10. Screen: Manufacturer's name <u>certain teed</u> Type <u>PVC</u> Dia. <u>5 1/2</u> Slot/groove <u>1/16</u> Length <u>40'</u> Set between <u>65</u> ft. and <u>105</u> ft. _____ ft. and _____ ft. Gravel pack? <input checked="" type="checkbox"/> Size range of material <u>3/4-3/8-1/2</u>
11. Static water level: _____ mo./day/yr. <u>48'</u> ft. below land surface Date <u>9-25-79</u>
12. Pumping level below land surfaces: <u>NA</u> _____ ft. after _____ hrs. pumping _____ g.p.m. _____ ft. after _____ hrs. pumping _____ g.p.m. Estimated maximum yield _____ g.p.m.
13. Water sample submitted: _____ mo./day/yr. <input checked="" type="checkbox"/> Yes <input type="checkbox"/> No Date <u>9-25-79</u>
14. Well head completion: <u>NO</u> less adapter _____ Inches above grade
15. Well grouted? <input checked="" type="checkbox"/> With: <input checked="" type="checkbox"/> Neat cement <input type="checkbox"/> Bentonite <input type="checkbox"/> Concrete Depth: From <u>0</u> ft. to <u>10</u> ft.
16. Nearest source of possible contamination: ft. <u>75</u> Direction <u>west</u> Type <u>septic tank</u> Well disinfected upon completion? <u>HTH</u> Yes <input type="checkbox"/> No <input type="checkbox"/>
17. Pump: <input checked="" type="checkbox"/> Not installed Manufacturer's name _____ Model number _____ HP _____ Volts _____ Length of drop pipe _____ ft. capacity _____ g.p.m. Type: <input type="checkbox"/> Submersible <input type="checkbox"/> Turbine <input type="checkbox"/> Jet <input type="checkbox"/> Reciprocating <input type="checkbox"/> Centrifugal <input type="checkbox"/> Other

18. Elevation: Topography: <input type="checkbox"/> Hill <input type="checkbox"/> Slope <input checked="" type="checkbox"/> Upland <input type="checkbox"/> Valley	19. Remarks: 1752
---	---------------------------------

20. Water well contractor's certification: This well was drilled under my jurisdiction and this report is true to the best of my knowledge and belief. Rosencrantz-Bemis 134 Business name _____ License No. _____ Address Box 713 Great Bend, Ks. Signed <u>Freddie Dodson</u> Date <u>10/15/74</u> Authorized representative
--

T 18
 R 11
 W 18
 E 26
 S 26
 Sec 26
 1/4 SW NE
 1/4 NE