


USE TYPEWRITER OR BALL POINT PEN-PRESS FIRMLY, PRINT CLEARLY.

WATER WELL RECORD
KSA 82a-1201-1215

Kansas Department of Health and Environment-Division of Environment (Water well Contractors) Topeka, Kansas 66620

1. Location of well: County Barton Fraction nw 1/4 nw 1/4 sw 1/4 Section number 32 Township number T 18 S R 11 Range number EW

2. Distance and direction from nearest town or city: 1 1/2 mi. of Ellinwood, Ks. Street address of well location if in city: 52-A
3. Owner of well: B & B Drilling Co. R.R. or street: 720 Union Center City, state, zip code: Wichita, Kansas 67202

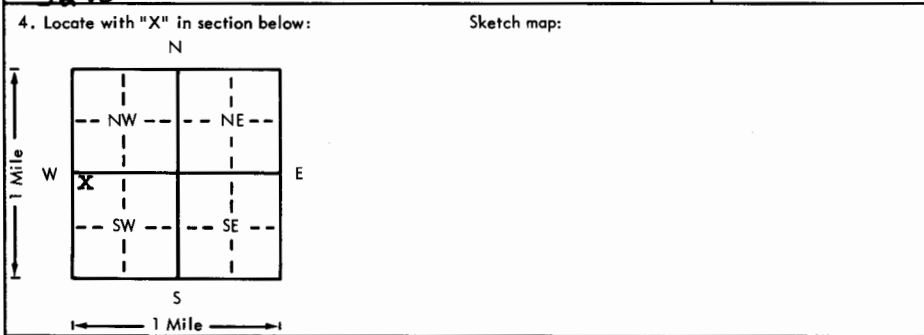

6. Bore hole dia. 8 in. Completion date _____
Well depth 140 ft. 9-16-75
7. Cable tool Rotary Driven Dug
 Hollow rod Jetted Bored Reverse rotary
8. Use: Domestic Public supply Industry
 Irrigation Air conditioning Stock
 Lawn Oil field water Other
9. Casing: Material pvc Height: Above or below base
Threaded _____ Welded _____ Surface 18 in.
RMP _____ PVC Weight _____ lbs./ft.
Dia. 4 in. to 140 ft. depth Wall Thickness: inches or
Dia. _____ in. to _____ ft. depth gage No. .237

5. Type and color of material	From	To
Top soil	0	2
brown clay	2	11
sand rock	11	22
Yellow brown light gray clay	22	30
sand rock	30	48
red & gray clay	48	75
sand rock	75	80
red blue gray clay	80	108
sandy blue clay w/some sand rock streaks	108	128
sand rock sandy shale	128	140
(Use a second sheet if needed)		

10. Screen: Manufacturer's name CertainTeed
Type pvc Dia. _____
Slot 1/16 Length 40
Set between 100 ft. and 140 ft.
_____ ft. and _____ ft.
Gravel pack? Size range of material 3/4 3/8
11. Static water level: _____ mo./day/yr.
47 ft. below land surface Date 9-16-75
12. Pumping level below land surfaces: na
_____ ft. after _____ hrs. pumping _____ g.p.m.
_____ ft. after _____ hrs. pumping _____ g.p.m.
Estimated maximum yield _____ g.p.m.
13. Water sample submitted: _____ mo./day/yr.
Yes No _____ Date _____
14. Well head completion: _____ Pitless adapter _____ Inches above grade
15. Well grouted?
With: Neat cement Bentonite Concrete
Depth: From 0 ft. to 10 ft.
16. Nearest source of possible contamination: _____ ft. 150 Direction nw Type oilwell
Well disinfected upon completion? Yes _____ No _____
17. Pump: Not installed
Manufacturer's name _____
Model number _____ HP _____ Volts _____
Length of drop pipe _____ ft. capacity _____ g.p.m.
Type:
 Submersible Turbine
 Jet Reciprocating
 Centrifugal Other

18. Elevation:
Topography:
 Hill
 Slope
 Upland
 Valley

19. Remarks:

20. Water well contractor's certification:
This well was drilled under my jurisdiction and this report is true to the best of my knowledge and belief.
Rosencrantz-Bemis 134
Business name License No.
Address Great Bend, Kansas 67530
Signed S. Kilgore Date 10/17/79
Authorized representative

T 18 S R 11 E Sec 32 NW 1/4 1/4