

USE TYPEWRITER OR BALL POINT PEN-PRESS FIRMLY, PRINT CLEARLY.


T R EW sec 1/4 1/4 1/4 No.

WATER WELL RECORD  
KSA 82a-1201-1215

Kansas State Dept. Of Health  
(Water Well Contractors)  
Forbes-Bldg. 740  
Topeka, Kansas 66620

1 Location of well:	County <b>Barton</b>	Township name	Fraction <b>nw/nw/sw <math>\frac{1}{4}</math></b>	Section number <b>32</b>	Town number <b>18</b>	Range number <b>11</b>
---------------------	-------------------------	---------------	--	-----------------------------	--------------------------	---------------------------

Distance and direction from nearest town or city: <b>4 <math>\frac{1}{2}</math> north of Ellinwood, Ks</b> Street address of well location if in city:	3 Owner of well: <b>B &amp; B Drilling</b> Address: <b>720 Union Center Wichita, Kansas</b>
--	--

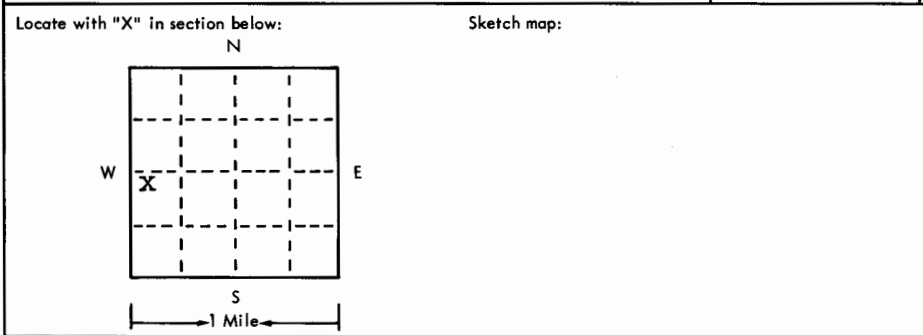

4 Well depth: <u>140</u> ft. Date of completion <u>9/16/75</u> Well diameter <u>7 7/8</u> .
5 <input type="checkbox"/> Cable tool <input checked="" type="checkbox"/> Rotary <input type="checkbox"/> Driven <input type="checkbox"/> Dug <input type="checkbox"/> Hollow rod <input type="checkbox"/> Jetted <input type="checkbox"/> Bored <input type="checkbox"/> Reverse rotary
6 Use: <input type="checkbox"/> Domestic <input type="checkbox"/> Public supply <input checked="" type="checkbox"/> Industry <input type="checkbox"/> Irrigation <input type="checkbox"/> Air conditioning <input type="checkbox"/> Commercial <input type="checkbox"/> Test well <input type="checkbox"/>
7 Casing: Material <u>PVC</u> Height: above/below Threaded <input type="checkbox"/> Welded <input checked="" type="checkbox"/> Surface <u>18</u> in. above Diam. <u>4</u> in. Weight <u>160</u> lbs./ft. — <u>4</u> in. to <u>100</u> ft. depth Drive shoe? <input type="checkbox"/> Yes <input type="checkbox"/> No — in. to — ft. depth!

2	Type and color of material	From	To
	Top soil	0	2
	Brown clay	2	11
	Sand rock	11	22
	Yellow brown light gray clay	22	30
	Sand rock	30	48
	Red and gray clay	48	73
	Sand rock	73	80
	Red & blue gray clay	80	108
	Sandy blue clay	108	128
	Sand rock and sandy shale	128	140
	(use a second sheet if needed)		

8 Screen: Manufacturer <u>R &amp; B</u> Type <u>PVC</u> Dia. <u>4</u> Slot/gauze <u>1/16</u> Length <u>40</u> Set between <u>100</u> ft. and <u>140</u> ft. Fittings: <u>3/4-3/8-1/2</u> Gravel pack <input checked="" type="checkbox"/> Yes <input type="checkbox"/> No Size range of material <u>CM-3</u>
9 Static water level: <u>47</u> ft. below land surface Date <u>9/16/75</u>
10 Pumping level below land surfaces: — ft. after — hrs. pumping <u>NA</u> g.p.m. — ft. after — hrs. pumping — g.p.m. Estimated maximum yield — g.p.m.
11 Water sample submitted: <input type="checkbox"/> Yes <input checked="" type="checkbox"/> No Date —
12 Well head completion: <input type="checkbox"/> Pitless adapter <u>13</u> inches above grade
13 Well grouted? <input type="checkbox"/> Yes <input type="checkbox"/> No <input type="checkbox"/> Neat cement <input type="checkbox"/> Bentonite <input type="checkbox"/> Depth: From — ft. to — ft.
14 Nearest source of possible contamination: ft. <u>150</u> Direction <u>NW</u> Type <u>oil</u> well Well disinfected upon completion? <input type="checkbox"/> Yes <input type="checkbox"/> No
15 Pump: <input checked="" type="checkbox"/> Not installed Manufacturer's name — Model number — HP — Volts — Length of drop pipe — ft. capacity — g.m.p. Type: <input type="checkbox"/> Submersible <input type="checkbox"/> Turbine <input type="checkbox"/> Jet <input type="checkbox"/> Reciprocating <input type="checkbox"/> Centrifugal <input type="checkbox"/> Other

16 Remarks: elevation

*well was pulled & plugged w/ gravel pack*

Topography:  
 Hill  
 Slope  
 Upland  
 Valley

Water well contractor's certification:  
This well was drilled under my jurisdiction and this report is true to the best of my knowledge and belief.

Rosencrantz-Bemis 134  
Business name License No.  
Address Great Bend, Ks.  
Signed Frederick Palmer Date 9/17/80  
Authorized representative

18 well 110032 NW 1/4 Sec 32