


1	LOCATION OF WATER WELL:	Fraction	Section Number	Township Number	Range Number
	County: Barton	SW 1/4 NE 1/4 NW 1/4	17	T 18 S R	11 E <b>(W)</b>

Distance and direction from nearest town or city street address of well if located within city?  
 Approximately 2 1/8 miles south and 1 3/4 miles west of Clafin

2 WATER WELL OWNER: Barton County Community College  
 RR#, St. Address, Box # 245 NE 30th Rd. Board of Agriculture, Division of Water Resources  
 City, State, ZIP Code Great Bend, KS 67530 Application Number: 46,764

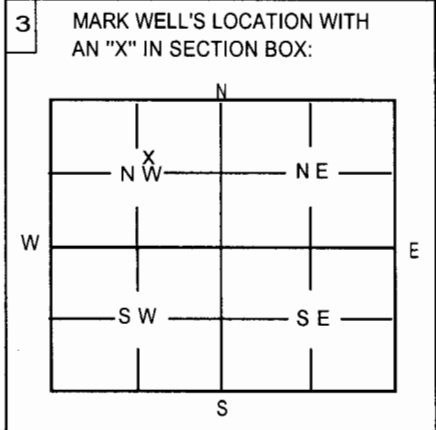

4 DEPTH OF WELL 142 ft  
 WELL'S STATIC WATER LEVEL 28.32 ft.  
 WELL WAS USED AS:  
 1 Domestic 5 Public Water Supply 9 Dewatering  
 2 Irrigation 6 Oil Field Water Supply 10 Monitoring Well  
 3 Feedlot 7 Domestic (Lawn & Garden) 11 Injection Well  
 4 Industrial 8 Air Conditioning 12 Other  
 Was a chemical / bacteriological sample submitted to Department? Yes No   
 If yes, mo/day/yr sample was submitted \_\_\_\_\_  
 Water Well Disinfected: Yes  No

5 TYPE OF BLANK CASING USED:  
 1 Steel 3 RMP (SR) 5 Wrought 7 Fiberglass 9 Other (Specify below)  
 2 PVC 4 ABS 6 Asbestos-Cement 8 Concrete Tile  
 Blank casing diameter 5 in. Was casing pulled? Yes No   
 Casing height above or below land surface 48 in. If yes, how much \_\_\_\_\_

6 GROUT PLUG MATERIAL: 1 Neat Cement 2 Cement grout 3 Bentonite 4 Other Bentonite Holeplug  
 Grout Plug Intervals: From \_\_\_\_\_ ft. to \_\_\_\_\_ ft., From \_\_\_\_\_ ft. to \_\_\_\_\_ ft. From 28 ft. to 0 ft.  
 What is the nearest source of possible contamination:  
 1 Septic tank 6 Seepage pit 11 Fuel storage 16 Other (specify below)  
 2 Sewer lines 7 Pit privy 12 Fertilizer storage  
 3 Watertight sewer lines 8 Sewage lagoon 13 Insecticide storage None known  
 4 Lateral lines 9 Feedyard 14 Abandoned water well  
 5 Cess Pool 10 Livestock pens 15 Oil well/Gas well  
 Direction from well? \_\_\_\_\_ How many feet? \_\_\_\_\_

FROM	TO	PLUGGING MATERIALS
142	28	Chlorinated Sand
28	0	Bentonite Holeplug

7 CONTRACTOR'S OR LANDOWNER'S CERTIFICATION: This water well was plugged under my jurisdiction and was completed on (mo/day/year) 03-03-08 and this record is true to the best of my knowledge and belief. Kansas Water Well Contractor's License No. 771 This Water Well Record was completed on (mo/day/year) 03-04-08 under the business name of Clarke Well & Equipment, Inc.  
 by (signature) *[Signature]*