
| | | RECORD | | WWC-5 | | Division of Wa | | | | MW-1D | |
|---|--------------------------------------------------------------------------------------------|----------------------------|----------------------|----------------------------|--------------|------------------|-----------------------------------------------------------------------------------------|------------------------------------------------|-----------------------------------------|-------------------|--|
| | | Correction | | ge in Well Use | | esources App. | | | Well ID | ., , | |
| | | WATER WEL | L: | Fraction | | ection Num | ber | Township Numb | | ge Number | |
| County: Barton NE ¼ NW ¼ NE ¼ NE ¼ 4 T 18 S R 11 □ E 2 WELL OWNER: Last Name: First: Street or Rural Address where well is located (if unknown, distance and | | | | | | | | | | | |
| | OWNER: | | | First: | | | | | | | |
| Business: Kansas Dept. of Health and Environment Address: 1000 SW Jackson St. Ste. 400 | | | | | | | | | neck nere: | | |
| Address: 1000 SW Jackson St., Ste. 400 Address: 1000 SW Jackson St., Ste. 400 1097 NE 130 Ave., Claflin | | | | | | | | | | | |
| City: | Topeka | | State: KS | ZIP: 66612 | | | | | | | |
| 3 LOCAT | | 4 DEPTH | OF COL | | 117 | A 5 T 4 | ···· | 38.52151 | 94 | (1.1.1 | |
| Double Communication Engineered 1) | | | | | | | | le: -98.5388 | N83 | (decimal degrees) | |
| | ON BOX: | | | 3) ft., or 4) | | | | le: | | | |
| WELL'S STATIC WATER LEVEL: | | | | | | | | Latitude/Longitude | | 33 LI NAD 27 | |
| below land surface, measured on (mo-day-yr | | | | | | | | unit make/model: | | | |
| NW- | above land surface, measured on (mo-day-yr). | | | | | | | WAAS enabled? | | | |
| Pump test data: Well water was ft. | | | | | | | | Survey Topogra | | | |
| W | W after hours pumping gpi | | | | | | Online Mapper: | | | | |
| sw | Well water was | | | | | | | | | | |
| | | Estimated V | Stimated Vield: gnm | | | 6 Elevation: | | | ☐ Ground | Level TOC | |
| S Bore Hole Diame | | |)iameter: | meter:7 in. to121 ft. and | | | Source: Land Survey GPS Topographic Map | | | | |
| 1 mile in. to ft. | | | | | | | ☐ Other | | | | |
| 7 WELL WATER TO BE USED AS: | | | | | | | | | | | |
| 1. Domestic | | | | ater Supply: well ID | | | | eld Water Supply: le | | | |
| | Household 6. Dewatering: how many wells? | | | | | 11. Tes | 11. Test Hole: well ID | | | | |
| | ☐ Lawn & Garden ☐ Livestock 7. ☐ Aquifer Recharge: well ID | | | | | 🔟 🤇 | ☐ Cased ☐ Uncased ☐ Geotechnical 12. Geothermal: how many bores? | | | | |
| 2. Irrigat | | | | al Remediation: well I | | | | | | | |
| 3. Feedle | | | Air Sparge | | | | a) Closed Loop ☐ Horizontal ☐ Vertical b) Open Loop ☐ Surface Discharge ☐ Inj. of Water | | | | |
| 4. Indust | | | Recovery | | LAGGOTTON | | | (specify): | | | |
| Was a chemical/bacteriological sample submitted to KDHE? Yes No If yes, date sample was submitted: | | | | | | | | | | | |
| Water well disinfected? \square Yes \square No | | | | | | | | | | | |
| 8 TYPE OF CASING USED: Steel PVC Other CASING JOINTS: Glued Clamped Welded Threaded | | | | | | | | | | | |
| Casing diameter 2 | | | | | | | | | | | |
| Casing height above land surface | | | | | | | | | | | |
| TYPE OF SCREEN OR PERFORATION MATERIAL: | | | | | | | | | | | |
| ☐ Steel ☐ Stainless Steel ☐ Fiberglass ☐ PVC ☐ Other (Specify) | | | | | | | | | | | |
| ☐ Brass ☐ Galvanized Steel ☐ Concrete tile ☐ None used (open hole) | | | | | | | | | | | |
| SCREEN OR PERFORATION OPENINGS ARE: | | | | | | | | | | | |
| ☐ Continuous Slot ☐ Mill Slot ☐ Gauze Wrapped ☐ Torch Cut ☐ Drilled Holes ☐ Other (Specify) | | | | | | | | | | | |
| □ Louvered Shutter □ Key Punched □ Wire Wrapped □ Saw Cut □ None (Open Hole) SCREEN-PERFORATED INTERVALS: From197 ft., From ft., From ft., From ft., From ft. | | | | | | | | | | | |
| SCICEEN- | DAVET DA | CV INTERVA | LS: From | 104 121 | π., From | ιπ. | 10 | π., From | π. το . | π. | |
| GRAVEL PACK INTERVALS: From 104 ft. to 121 ft., From ft. to ft., From ft. to ft. 9 GROUT MATERIAL: Neat cement Cement grout Reptonite Other Concrete | | | | | | | | | | | |
| 9 GROUT MATERIAL: ☐ Neat cement ☐ Cement grout ☐ Bentonite ☐ Other Concrete Grout Intervals: From 0 ft. to 3 ft., From ft. to 104 ft., From ft. to ft. | | | | | | | | | | | |
| Nearest source of possible contamination: | | | | | | | | | | | |
| ☐ Septic | | | ateral Line | s Pit Privy | | Livestock P | ens | ☐ Insectic | ide Storage | | |
| ☐ Sewer | | | ess Pool | ☐ Sewage La | | Fuel Storag | | | ned Water V | Vell | |
| | ☐ Watertight Sewer Lines ☐ Seepage Pit ☐ Feedyard ☐ Fertilizer Storage ☐ Oil Well/Gas Well | | | | | | | | | | |
| □ Other (Specify) Direction from well? ft. | | | | | | | | | | | |
| 10 FROM | TO | | THOLOG | | | | | | DILICONIO | TRITEDUATE | |
| 0 | 3 | Clay with silt | THULUC | JIC LUG | 76.5 | TO 82.5 | + | HO. LOG (cont.) or | LLUGGING | INTERVALS | |
| 3 | 9 | Clay With Sitt | | | 82.5 | 116 | Clay | some sand | | | |
| 9 | 11 | Sand, vf, som | ne silt | | 116 | 119 | | | nd | | |
| 11 | 47.5 | Clay, Brown | ic siit | | 119 | 121 | | <u>/, some silt, tr. sa</u> d, f, some silt | ıı ıu | | |
| 47.5 | 52 | Clay w/silt | | | | 121 | Jan | u, i, some Sill | | | |
| 52 | 55.5 | Sand, f | | | | + | | | | | |
| 55.5 | 63 | Sand, r Clay, some silt | | | Notes: | 1 | L | | | | |
| | 63 71 Clay | | | | | | | | | | |
| 71 | | | | | | | | | | | |
| 71 76.5 Clay, Lt. Gray | | | | | | | | | | | |
| under my jurisdiction and was completed on (mo-day-year) .4/23/2019 and this record is true to the best of my knowledge and belief. | | | | | | | | | | | |
| Kansas Wa | iter Well Co | ntractor's Lice | nse No5 | 27 This Wa | ter Well Re | ecord was co | mple | ted on (mo-day-ye | ar) 5/13/2 | 01.9 | |
| under the b | usiness nan | ne of GeoCor | <u>a. LLC</u> | 27 This Wa | | Signature | <u>x</u> | Jale Klof. | • • • • • • • • • • • • • • • • • • • • | | |
| Mail | 1 white copy a | long with a fee of \$ | 5.00 for <u>eacl</u> | h constructed well to: Kar | sas Departme | nt of Health and | d Envir | onment, Bureau of Wa | ter, GWTS Se | ection, | |
| | | | | 66612-1367. Mail one to | | | one for | your records. Telepho | | | |
| Visit us at http | p://www.kdhek | s.gov/waterwell/in | aex.ntml | | KSA 82a-1 | <u> </u> | | | Revised | 7/10/2015 | |

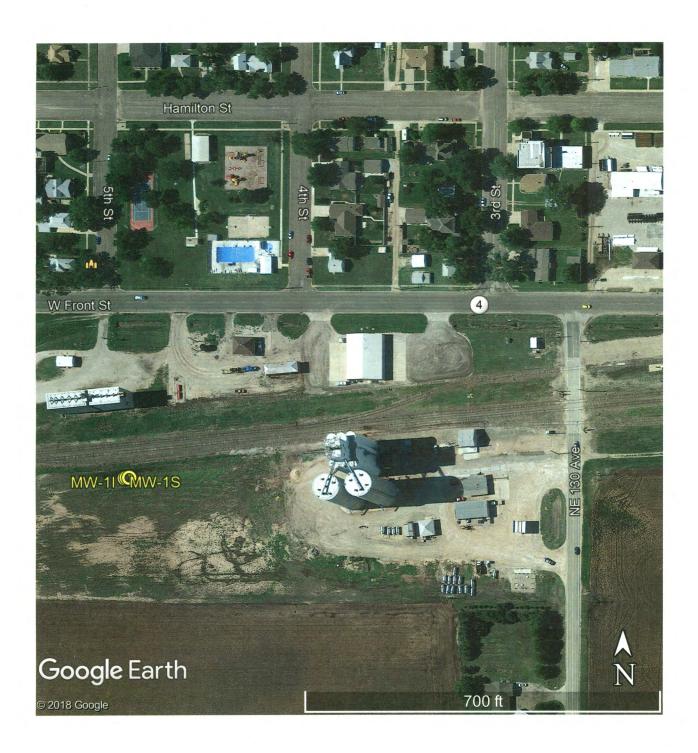

Facility Address: Central Prairie Coop 1097 NE 130 Ave., Claflin Well Owner: KDHE

GPS Coordinates:

MW-1S: 38.5215222, -98.5387778 MW-1I: 38.5215222, -98.5387944 MW-1D: 38.5215194, -98.5388083 RECEIVED

MAY 29 2019

BUREAU OF WATER