


1 LOCATION OF WATER WELL: Fraction Section Number Township Number Range Number
 County: Barton SE 1/4 SE 1/4 SW 1/4 12 T 18 S R 12W E/W

Distance and direction from nearest town or city street address of well if located within city?
 5 E, 2 1/2 S of Hoisington, Kansas

2 WATER WELL OWNER: Alfred Hammeke
 RR#, St. Address, Box #: Route 2 Board of Agriculture, Division of Water Resources
 City, State, ZIP Code: Claflin, Kansas 67525 Application Number:

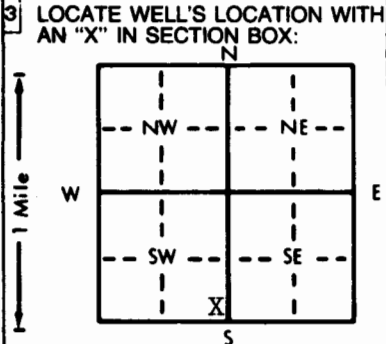

4 DEPTH OF COMPLETED WELL... 80... ft. ELEVATION: Unknown
 Depth(s) Groundwater Encountered 1. 50... ft. 2. ... ft. 3. ... ft.
 WELL'S STATIC WATER LEVEL... 50. ft. below land surface measured on mo/day/yr... 2/27/92
 Pump test data: Well water was... ft. after... hours pumping... gpm
 Est. Yield... gpm: Well water was... ft. after... hours pumping... gpm
 Bore Hole Diameter... in. to 80... ft., and... in. to... ft.
 WELL WATER TO BE USED AS: 5 Public water supply 8 Air conditioning 11 Injection well
~~XXXXXX~~ 3 Feedlot 6 Oil field water supply 9 Dewatering 12 Other (Specify below)
 2 Irrigation 4 Industrial 7 Lawn and garden only 10 Monitoring well
 Was a chemical/bacteriological sample submitted to Department? Yes... No...; If yes, mo/day/yr sample was submitted
 Water Well Disinfected? Yes No

5 TYPE OF BLANK CASING USED: 5 Wrought iron 8 Concrete tile CASING JOINTS: Glued... Clamped...
 1 Steel 3 RMP (SR) 6 Asbestos-Cement 9 Other (specify below) Welded...
 2 PVC 4 ABS 7 Fiberglass... Threaded...
 Blank casing diameter... 5... in. to 60... ft., Dia... in. to... ft., Dia... in. to... ft.
 Casing height above land surface... 12... in., weight... 2.8... lbs./ft. Wall thickness or gauge No. Sch. 40
 TYPE OF SCREEN OR PERFORATION MATERIAL: 7 PVC 10 Asbestos-cement
 1 Steel 3 Stainless steel 5 Fiberglass 8 RMP (SR) 11 Other (specify)
 2 Brass 4 Galvanized steel 6 Concrete tile 9 ABS 12 None used (open hole)
 SCREEN OR PERFORATION OPENINGS ARE: 5 Gauzed wrapped 8 Saw cut 11 None (open hole)
 1 Continuous slot 3 Mill slot 6 Wire wrapped 9 Drilled holes
 2 Louvered shutter 4 Key punched 7 Torch cut 10 Other (specify)
 SCREEN-PERFORATED INTERVALS: From... 60... ft. to 80... ft., From... ft. to... ft.
 GRAVEL PACK INTERVALS: From... 20... ft. to 80... ft., From... ft. to... ft.

6 GROUT MATERIAL: 1 Neat cement 2 Cement grout 3 Bentonite 4 Other
 Grout Intervals: From... 0... ft. to 20... ft., From... ft. to... ft., From... ft. to... ft.
 What is the nearest source of possible contamination: 10 Livestock pens 14 Abandoned water well
 1 Septic tank 4 Lateral lines 7 Pit privy 11 Fuel storage 15 Oil well/Gas well
 2 Sewer lines 5 Cess pool 8 Sewage lagoon 12 Fertilizer storage 16 Other (specify below)
 3 Watertight sewer lines 6 Seepage pit 9 Feedyard 13 Insecticide storage
 Direction from well? South How many feet? 100

FROM	TO	LITHOLOGIC LOG	FROM	TO	PLUGGING INTERVALS
0	5	Clay			
5	38	Shale			
38	80	Sand rock			

7 CONTRACTOR'S OR LANDOWNER'S CERTIFICATION: This water well was (1) constructed, (2) reconstructed, or (3) plugged under my jurisdiction and was completed on (mo/day/year) 2/27/92 and this record is true to the best of my knowledge and belief. Kansas Water Well Contractor's License No. 186. This Water Well Record was completed on (mo/day/yr) 3/30/92 under the business name of Kelly's Water Well Service by (signature)