


1 LOCATION OF WATER WELL:	Fraction	Section Number	Township Number	Range Number
County: <u>Barton</u>	<u>NW</u> ¼ <u>NW</u> ¼ <u>NW</u> ¼	<u>6</u>	<u>T</u> <u>18</u> <u>S</u>	<u>R</u> <u>12</u> <u>W</u>

Distance and direction from nearest town or city street address of well if located within city?
8 west ¼ south of Claflin, Ks.

2 WATER WELL OWNER: Larry & Celia Nicholson
 RR#, St. Address, Box # : 3705 Cauntry Lane
 City, State, ZIP Code : Hays, Ks. 67601
 Board of Agriculture, Division of Water Resources
 Application Number: 864

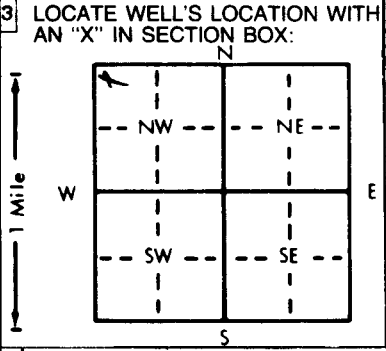

4 DEPTH OF COMPLETED WELL... 55 ft. ELEVATION:

Depth(s) Groundwater Encountered 1. ft. 2. ft. 3. ft.

WELL'S STATIC WATER LEVEL ... 16 ft. below land surface measured on mo/day/yr ... 12-1-94

Pump test data: Well water was ft. after hours pumping gpm

Est. Yield ... na gpm: Well water was ft. after hours pumping gpm

Bore Hole Diameter ... 10 in. to ... 55 ft., and in. to ft.

WELL WATER TO BE USED AS:

5 Public water supply	8 Air conditioning	11 Injection well
<u>1</u> Domestic	3 Feedlot	6 Oil field water supply
2 Irrigation	4 Industrial	7 Lawn and garden only
		9 Dewatering
		10 Monitoring well
		12 Other (Specify below)
		<u>live stock</u>

Was a chemical/bacteriological sample submitted to Department? Yes.....No... X.....; If yes, mo/day/yr sample was submitted

Water Well Disinfected? Yes hth No

5 TYPE OF BLANK CASING USED:

1 Steel	3 RMP (SR)	5 Wrought iron	8 Concrete tile	CASING JOINTS: Glued <u>X</u> Clamped
<u>2 PVC</u>	4 ABS	6 Asbestos-Cement	9 Other (specify below)	Welded
		7 Fiberglass		Threaded

Blank casing diameter 5 in. to ... 35 ft., Dia in. to ft., Dia in. to ft.

Casing height above land surface 2½ in., weight 258 lbs./ft. Wall thickness or gauge No.

TYPE OF SCREEN OR PERFORATION MATERIAL: 7 PVC 10 Asbestos-cement

1 Steel	3 Stainless steel	5 Fiberglass	8 RMP (SR)	11 Other (specify)
2 Brass	4 Galvanized steel	6 Concrete tile	9 ABS	12 None used (open hole)

SCREEN OR PERFORATION OPENINGS ARE:

1 Continuous slot	3 Mill slot	5 Gauzed wrapped	<u>8 Saw cut</u>	11 None (open hole)
2 Louvered shutter	4 Key punched	6 Wire wrapped	9 Drilled holes	
		7 Torch cut	10 Other (specify)	

SCREEN-PERFORATED INTERVALS: From ... 35 ft. to ... 55 ft., From ft. to ft.

GRAVEL PACK INTERVALS: From ... 55 ft. to ... 20 ft., From ft. to ft.

6 GROUT MATERIAL: 1 Neat cement 2 Cement grout 3 Bentonite 4 Other hole plug

Grout Intervals: From ... 0 ft. to ... 20 ft., From ft. to ft., From ft. to ft.

What is the nearest source of possible contamination:

1 Septic tank	4 Lateral lines	7 Pit privy	10 Livestock pens	14 Abandoned water well
2 Sewer lines	5 Cess pool	8 Sewage lagoon	11 Fuel storage	15 Oil well/Gas well
3 Watertight sewer lines	6 Seepage pit	9 Feedyard	12 Fertilizer storage	16 Other (specify below)
			13 Insecticide storage	<u>none</u>

Direction from well? How many feet?

FROM	TO	LITHOLOGIC LOG	FROM	TO	PLUGGING INTERVALS
0	3	Top soil			
3	29	Tan clay			
29	41	Gritty clay			
41	54	Broken rock			
54	55	Shale			

7 CONTRACTOR'S OR LANDOWNER'S CERTIFICATION: This water well was (1) constructed, (2) reconstructed, or (3) plugged under my jurisdiction and was completed on (mo/day/year) 12-1-94 and this record is true to the best of my knowledge and belief. Kansas Water Well Contractor's License No. 134 This Water Well Record was completed on (mo/day/yr) 12-16-94 under the business name of Rosencrantz-Bemis by (signature) Maedia Nelson

INSTRUCTIONS: Use typewriter or ball point pen. PLEASE PRESS FIRMLY and PRINT clearly. Please fill in blanks, underline or circle the correct answers. Send top three copies to Kansas Department of Health and Environment, Bureau of Water, Topeka, Kansas 66620-0001. Telephone: 913-296-5545. Send one to WATER WELL OWNER and retain one for your records.