


WATER WELL RECORD Form WWC-5 KSA 82a-1212

1 LOCATION OF WATER WELL: County: Barton Fraction: SE 1/4 NW 1/4 SW 1/4 Section Number: 4 Township Number: T 18 S Range Number: R 13 EW

Distance and direction from nearest town or city street address of well if located within city? UP Rail Yard, Hoisington Ks MW-17

2 WATER WELL OWNER: USPCI RR#, St. Address, Box #: 5665 Flat Iron Pkwy Board of Agriculture, Division of Water Resources City, State, ZIP Code: Boulder Co. 80301 Application Number:

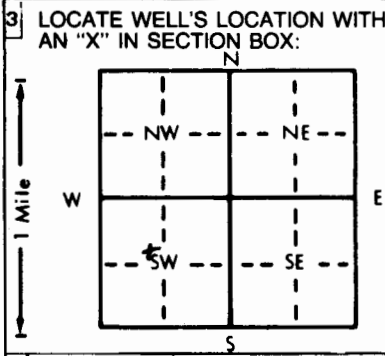

3 LOCATE WELL'S LOCATION WITH AN "X" IN SECTION BOX: 4 DEPTH OF COMPLETED WELL: 25 ft. ELEVATION: 14 ft. below land surface... WELL'S STATIC WATER LEVEL: 14 ft. below land surface... PUMP TEST DATA: Well water was 0 gpm... hours pumping... EST. YIELD: 0 gpm... hours pumping... BORE HOLE DIAMETER: 8 in. to 25 in. to... WELL WATER TO BE USED AS: 10 Monitoring well... WAS A CHEMICAL/BACTERIOLOGICAL SAMPLE SUBMITTED TO DEPARTMENT? No... WATER WELL DISINFECTED? No

5 TYPE OF BLANK CASING USED: 2 PVC, 3 RMP (SR), 4 ABS, 7 Fiberglass, 8 Concrete tile, 9 Other (specify below), 10 Asbestos-cement. CASING JOINTS: Glued, Clamped, Welded, Threaded. TYPE OF SCREEN OR PERFORATION MATERIAL: 7 PVC, 10 Asbestos-cement. SCREEN OR PERFORATION OPENINGS ARE: 3 Mill slot, 4 Key punched, 5 Gauzed wrapped, 8 Saw cut, 11 None (open hole). SCREEN-PERFORATED INTERVALS: From 10 ft. to 25 ft. GRAVEL PACK INTERVALS: From 9 ft. to 25 ft.

6 GROUT MATERIAL: 3 Bentonite, 4 Other. Grout Intervals: From 0 ft. to 9 ft. What is the nearest source of possible contamination: 11 Fuel storage, 14 Abandoned water well, 15 Oil well/Gas well, 16 Other (specify below).

Direction from well? FROM TO LITHOLOGIC LOG FROM TO PLUGGING INTERVALS. Entry: 0 TD soft silty clay.

7 CONTRACTOR'S OR LANDOWNER'S CERTIFICATION: This water well was (1) constructed, (2) reconstructed, or (3) plugged under my jurisdiction and was completed on (mo/day/year) 3/30/92 and this record is true to the best of my knowledge and belief. Kansas Water Well Contractor's License No. 102. This Water Well Record was completed on (mo/day/year) 4-28-92 under the business name of Layne Western Co. Wichita by (signature) B. Meier

INSTRUCTIONS: Use typewriter or ball point pen. PLEASE PRESS FIRMLY and PRINT clearly. Please fill in blanks, underline or circle the correct answers. Send top three copies to Kansas Department of Health and Environment, Bureau of Water, Topeka, Kansas 66620-0001. Telephone: 913-296-5545. Send one to WATER WELL OWNER and retain one for your records.