


1 LOCATION OF WATER WELL: Fraction SE 1/4 NW 1/4 SW 1/4 Section Number 4 Township Number T 18 S Range Number R 13 EW

Distance and direction from nearest town or city street address of well if located within city? U.P. Railyard, Hoxington, KS MW 23

2 WATER WELL OWNER: USPCJ RR#, St. Address, Box #: 5665 Flatiron Pkwy, Boulder, Colo 80301 City, State, ZIP Code: Board of Agriculture, Division of Water Resources Application Number:

3 LOCATE WELL'S LOCATION WITH AN "X" IN SECTION BOX:

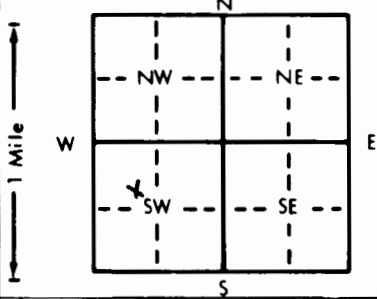

4 DEPTH OF COMPLETED WELL: 20 ft. ELEVATION: 10 ft. Depth(s) Groundwater Encountered: 10 ft. WELL'S STATIC WATER LEVEL: 10 ft. below land surface measured on mo/day/yr Pump test data: Well water was ... ft. after ... hours pumping ... gpm Est. Yield ... gpm Well water was ... ft. after ... hours pumping ... gpm Bore Hole Diameter: 8 in. to 20 ft. and ... in. to ... ft. WELL WATER TO BE USED AS: 5 Public water supply, 8 Air conditioning, 11 Injection well, 1 Domestic, 3 Feedlot, 6 Oil field water supply, 9 Dewatering, 12 Other (Specify below) 2 Irrigation, 4 Industrial, 7 Lawn and garden only, 0 Monitoring well

5 TYPE OF BLANK CASING USED: 1 Steel, 2 PVC, 3 RMP (SR), 4 ABS, 5 Wrought iron, 6 Asbestos-Cement, 7 Fiberglass, 8 Concrete tile, 9 Other (specify below) CASING JOINTS: Glued, Clamped, Welded, Threaded

Blank casing diameter: 2 in. to 5 ft., Dia. 24 in., weight ... lbs./ft. Wall thickness or gauge No. ...

TYPE OF SCREEN OR PERFORATION MATERIAL: 1 Steel, 2 Brass, 3 Stainless steel, 4 Galvanized steel, 5 Fiberglass, 6 Concrete tile, 7 PVC, 8 RMP (SR), 9 ABS, 10 Asbestos-cement, 11 Other (specify), 12 None used (open hole)

SCREEN OR PERFORATION OPENINGS ARE: 1 Continuous slot, 2 Louvered shutter, 3 Mill slot, 4 Key punched, 5 Gauzed wrapped, 6 Wire wrapped, 7 Torch cut, 8 Saw cut, 9 Drilled holes, 10 Other (specify), 11 None (open hole)

SCREEN-PERFORATED INTERVALS: From 5 ft. to 20 ft., From ... ft. to ... ft. GRAVEL PACK INTERVALS: From 3 ft. to 20 ft., From ... ft. to ... ft.

6 GROUT MATERIAL: 1 Neat cement, 2 Cement grout, 3 Bentonite, 4 Other Grout intervals: From 0 ft. to 3 ft., From ... ft. to ... ft.

What is the nearest source of possible contamination: 1 Septic tank, 2 Sewer lines, 3 Watertight sewer lines, 4 Lateral lines, 5 Cess pool, 6 Seepage pit, 7 Pit privy, 8 Sewage lagoon, 9 Feedyard, 10 Livestock pens, 11 Fuel storage, 12 Fertilizer storage, 13 Insecticide storage, 14 Abandoned water well, 15 Oil well/Gas well, 16 Other (specify below)

Direction from well? Within facility How many feet? Within

Table with columns for FROM, TO, LITHOLOGIC LOG, FROM, TO, PLUGGING INTERVALS. Entry: 0 TO TD soft silty clay

7 CONTRACTOR'S OR LANDOWNER'S CERTIFICATION: This water well was (1) constructed, (2) reconstructed, or (3) plugged under my jurisdiction and was completed on (mo/day/year) 12-4-92 and this record is true to the best of my knowledge and belief. Kansas Water Well Contractor's License No. 102 This Water Well Record was completed on (mo/day/yr) 12/16/92 under the business name of Rayne Wichita by (signature) Mueller