WATER WELL RECORD Form WWC-5 KSA 82a-1212

1 LOCATION OF WATER WELL: County: Barton	Fraction: SW ¼ NE ¼ NE ¼	Section Number: 5	Township Number: T 18 S	Range Number: R 13 E (W)

Distance and direction from nearest town or city street address of well if located within city?
300 North Elm Hoisington, Kansas

2 WATER WELL OWNER: Becky Hicks
RR#, St. Address, Box # : 300 North Elm
City, State, ZIP Code : Hoisington, Kansas 67544

Board of Agriculture, Division of Water Resources Application Number:

3 LOCATE WELL'S LOCATION WITH AN "X" IN SECTION BOX:

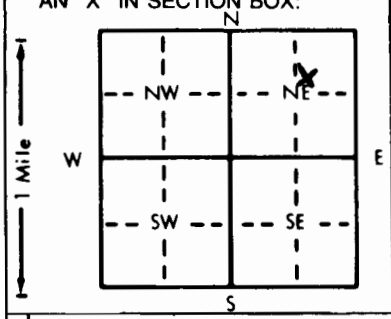

4 DEPTH OF COMPLETED WELL 63 ft. ELEVATION: Upland
Depth(s) Groundwater Encountered 1. 43 ft. 2. ft. 3. ft.
WELL'S STATIC WATER LEVEL 45 ft. below land surface measured on mo/day/yr 3/10/90
Pump test data: Well water was 45 ft. after 2 hours pumping 30 gpm
Est. Yield 30 gpm: Well water was ft. after hours pumping gpm
Bore Hole Diameter 10 in. to 63 ft., and in. to ft.
WELL WATER TO BE USED AS: 7
1 Domestic 3 Feedlot 5 Public water supply 6 Oil field water supply 7 Lawn and garden only 8 Air conditioning 9 Dewatering 10 Monitoring well 11 Injection well 12 Other (Specify below)
2 Irrigation 4 Industrial
Was a chemical/bacteriological sample submitted to Department? Yes No X ; If yes, mo/day/yr sample was submitted
Water Well Disinfected? Yes X No

5 TYPE OF BLANK CASING USED: 2
1 Steel 3 RMP (SR) 5 Wrought iron 6 Asbestos-Cement 8 Concrete tile 9 Other (specify below)
2 PVC 4 ABS 7 Fiberglass
CASING JOINTS: Glued X Clamped Welded Threaded
Blank casing diameter 5 in. to 43 ft., Dia in. to ft., Dia in. to ft.
Casing height above land surface 18 in., weight 2.29 lbs./ft. Wall thickness or gauge No. .26
TYPE OF SCREEN OR PERFORATION MATERIAL: 7
1 Steel 3 Stainless steel 5 Fiberglass 7 PVC 8 RMP (SR) 10 Asbestos-cement 11 Other (specify)
2 Brass 4 Galvanized steel 6 Concrete tile 9 ABS 12 None used (open hole)
SCREEN OR PERFORATION OPENINGS ARE: 8
1 Continuous slot 3 Mill slot 5 Gauzed wrapped 6 Wire wrapped 8 Saw cut 9 Drilled holes 11 None (open hole)
2 Louvered shutter 4 Key punched 7 Torch cut 10 Other (specify)
SCREEN-PERFORATED INTERVALS: From 43 ft. to 63 ft., From ft. to ft.
From ft. to ft., From ft. to ft.
GRAVEL PACK INTERVALS: From 20 ft. to 63 ft., From ft. to ft.
From ft. to ft., From ft. to ft.

6 GROUT MATERIAL: 1 1 Neat cement 2 Cement grout 3 Bentonite 4 Other
Grout Intervals: From 0 ft. to 20 ft., From ft. to ft., From ft. to ft.
What is the nearest source of possible contamination: None
1 Septic tank 4 Lateral lines 7 Pit privy 10 Livestock pens 14 Abandoned water well
2 Sewer lines 5 Cess pool 8 Sewage lagoon 11 Fuel storage 15 Oil well/Gas well
3 Watertight sewer lines 6 Seepage pit 9 Feedyard 12 Fertilizer storage 16 Other (specify below)
13 Insecticide storage
Direction from well? How many feet?

FROM	TO	LITHOLOGIC LOG	FROM	TO	PLUGGING INTERVALS
0	4	Topsoil			
4	43	Clay			
43	56	Sand and rock clay layers			
56	58	Clay			
58	63	Fine clay			

7 CONTRACTOR'S OR LANDOWNER'S CERTIFICATION: This water well was (1) constructed, (2) reconstructed, or (3) plugged under my jurisdiction and was completed on (mo/day/year) 3/10/90 and this record is true to the best of my knowledge and belief. Kansas Water Well Contractor's License No. 199 This Water Well Record was completed on (mo/day/yr) 4/5/90
under the business name of Karst Water Well Drilling & Service, Inc by (signature)

INSTRUCTIONS: Use typewriter or ball point pen. *PLEASE PRESS FIRMLY* and *PRINT* clearly. Please fill in blanks, underline or circle the correct answers. Send top three copies to Kansas Department of Health and Environment, Bureau of Water, Topeka, Kansas 66620-7320. Telephone: 913-296-5545. Send one to WATER WELL OWNER and retain one for your records.