


1 LOCATION OF WATER WELL:		Fraction	Section Number	Township Number	Range Number
County: <u>BARTON</u>		<u>SE</u> $\frac{1}{4}$ <u>SE</u> $\frac{1}{4}$ <u>NE</u> $\frac{1}{4}$	<u>5</u>	T <u>18</u> S	R <u>13</u> E <u>W</u>

2 WATER WELL OWNER: Herb's Conoco
RR#, St. Address, Box #: 202 N. Main
City, State, ZIP Code: Hoisington, KS

MW-9

Board of Agriculture, Division of Water Resources
Application Number:

4 DEPTH OF COMPLETED WELL.....35..... ft. ELEVATION:

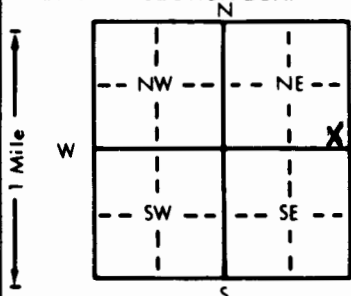

Depth(s) Groundwater Encountered 1. ft. 2. ft. 3. ft.

WELL'S STATIC WATER LEVEL 21.57 ft. below land surface measured on mo/day/yr

Pump test data: Well water was ft. after hours pumping gpm

Est. Yield gpm: Well water was ft. after hours pumping gpm

Bore Hole Diameter in. to ft., and in. to ft.

WELL WATER TO BE USED AS:

1 Domestic	3 Feedlot	6 Oil field water supply	9 Dewatering	11 Injection well
2 Irrigation	4 Industrial	7 Lawn and garden only	10 Monitoring well	12 Other (Specify below)

Was a chemical/bacteriological sample submitted to Department? Yes. No; If yes, mo/day/yr sample was submitted

Water Well Disinfected? Yes No

R)	5 Wrought iron	8 Concrete tile	CASING JOINTS: Glued Clamped
	6 Asbestos-Cement	9 Other (specify below)	Welded
	7 Fiberglass		Threaded.

Blank casing diameter 2 in. to 20 ft. Dia. in. to ft. Dia. in. to ft.
Casing height above land surface 0 in. weight lbs./ft. Wall thickness or gauge No.

10 Asbestos-cement
 11 Other (specify)
 12 None used (open hole)

ICS ARE:

fill slot

key punched

5 Gauzed wrapped

6 Wire wrapped

7 Torch cut

8 Saw cut

9 Drilled holes

10 Other (specify)

11 None (open hole)

SCREEN-PERFORATED INTERVALS:	From . . . <u>20</u> . . . ft. to . . . <u>35</u> . . . ft.	From ft. to ft.
	From ft. to ft.	From ft. to ft.
GRAVEL PACK INTERVALS:	From . . . <u>18</u> . . . ft. to . . . <u>35</u> . . . ft.	From ft. to ft.
	From ft. to ft.	From ft. to ft.

6 GROUT MATERIAL: 1 Neat cement 2 Cement grout 3 Bentonite 4 Other

Grout Intervals: From 0 ft. to 17 ft. From 17 ft. to 18 ft. From ft. to ft.

contamination:		10 Livestock pens	14 Abandoned water well
ral lines	7 Pit privy	11 Fuel storage	15 Oil well/Gas well
s pool	8 Sewage lagoon	12 Fertilizer storage	16 Other (specify below)
page pit	9 Feedyard	13 Insecticide storage	

Direction from well?

[illegible]

7 CONTRACTOR'S OR LANDOWNER'S CERTIFICATION: This water well was (1) constructed, (2) reconstructed, or (3) plugged under my jurisdiction and was completed on (mo/day/year) 12/9/93 and this record is true to the best of my knowledge and belief. Kansas Water Well Contractor's License No. 438 This Water Well Record was completed on (mo/day/yr) 3/10/94 under the business name of Kansas City Testing Laboratories by (signature) James L. Binkley

INSTRUCTIONS: Use typewriter or ball point pen. PLEASE PRESS FIRMLY and PRINT clearly. Please fill in blanks, underline or circle the correct answers. Send top three copies to Kansas Department of Health and Environment, Bureau of Water, Topeka, Kansas 66620-0001. Telephone: 913-296-5545. Send one to WATER WELL OWNER and retain one for your records.