

1 LOCATION OF WATER WELL: County: <u>Barton</u>	Fraction <u>SW</u> $\frac{1}{4}$ <u>SW</u> $\frac{1}{4}$ <u>SW</u> $\frac{1}{4}$	Section Number <u>28</u>	Township Number <u>T 18</u> <u>S</u>	Range Number <u>R 13W</u> <u>E/W</u>
--	---	-----------------------------	---	---

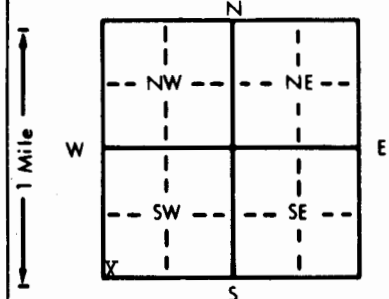
Distance and direction from nearest town or city street address of well if located within city?

4 S of Hoisington, Kansas2 WATER WELL OWNER: Mickey JacobsRR#, St. Address, Box # : Route 5City, State, ZIP Code : Great Bend, Kansas 67530

Board of Agriculture, Division of Water Resources

Application Number:

3 LOCATE WELL'S LOCATION WITH AN "X" IN SECTION BOX:

4 DEPTH OF COMPLETED WELL: 88 ft. ELEVATION: UnknownDepth(s) Groundwater Encountered 1. 50 ft. 2. 50 ft. 3. 10/20/88 ft.WELL'S STATIC WATER LEVEL 50 ft. below land surface measured on mo/day/yrPump test data: Well water was 20 ft. after 8 hours pumping 8 gpmEst. Yield 20 gpm: Well water was 8 ft. after 8 hours pumping 8 gpmBore Hole Diameter 8 in. to 88 ft., and 8 in. to 88 ft.

WELL WATER TO BE USED AS: 5 Public water supply 8 Air conditioning 11 Injection well

1 Domestic 3 Feedlot 6 Oil field water supply 9 Dewatering 12 Other (Specify below)

2 Irrigation 4 Industrial 7 Lawn and garden only 10 Monitoring well

Was a chemical/bacteriological sample submitted to Department? Yes No; If yes, mo/day/yr sample was sub-mitted Water Well Disinfected? Yes No

5 TYPE OF BLANK CASING USED:

1 Steel

3 RMP (SR)

5 Wrought iron

8 Concrete tile

CASING JOINTS: Glued Clamped

2 PVC

4 ABS

6 Asbestos-Cement

9 Other (specify below)

Welded

Blank casing diameter 5 in. to 68 ft., Dia. 5 in. to 68 ft., Dia. 5 in. to 68 ft.Casing height above land surface 120 in., weight 2.8 lbs./ft. Wall thickness or gauge No. Sch. 40

7 Fiberglass

Threaded

TYPE OF SCREEN OR PERFORATION MATERIAL:

1 Steel

3 Stainless steel

5 Fiberglass

8 RMP (SR)

10 Asbestos-cement

2 Brass

4 Galvanized steel

6 Concrete tile

9 ABS

11 Other (specify)

12 None used (open hole)

SCREEN OR PERFORATION OPENINGS ARE:

1 Continuous slot

3 Mill slot

5 Gauzed wrapped

8 Saw cut

11 None (open hole)

2 Louvered shutter

4 Key punched

6 Wire wrapped

9 Drilled holes

7 Torch cut

10 Other (specify)

SCREEN-PERFORATED INTERVALS: From 68 ft. to 88 ft., From 68 ft. to 88 ft., From 68 ft. to 88 ft.GRAVEL PACK INTERVALS: From 20 ft. to 88 ft., From 20 ft. to 88 ft., From 20 ft. to 88 ft.6 GROUT MATERIAL: 1 Neat cement 2 Cement grout 3 Bentonite 4 OtherGrout Intervals: From 0 ft. to 20 ft., From 0 ft. to 20 ft., From 0 ft. to 20 ft.

What is the nearest source of possible contamination:

1 Septic tank

4 Lateral lines

7 Pit privy

10 Livestock pens

14 Abandoned water well

2 Sewer lines

5 Cess pool

8 Sewage lagoon

11 Fuel storage

15 Oil well/Gas well

3 Watertight sewer lines

6 Seepage pit

9 Feedyard

12 Fertilizer storage

16 Other (specify below)

13 Insecticide storage

Direction from well? West How many feet? 100

FROM TO LITHOLOGIC LOG FROM TO PLUGGING INTERVALS

0 60 Clay

60 88 Sand rock

7 CONTRACTOR'S OR LANDOWNER'S CERTIFICATION: This water well was (1) constructed (2) reconstructed, or (3) plugged under my jurisdiction and was

completed on (mo/day/year) 10/20/88 and this record is true to the best of my knowledge and belief, KansasWater Well Contractor's License No. 186 This Water Well Record was completed on (mo/day/yr) 12/28/88under the business name of Kelly's Water Well Service by (signature) Kelly's Water Well Service