Cont'd

USE TYPEWRITER OR BALL POINT PEN-PRESS FIRMLY, PRINT CLEARLY.

WATER WELL RECORD
KSA 82a-1201-1215

Kansas Department of Health and Environment-Division of Environment
(Water well Contractors)
Topeka, Kansas 66620

1. Location of well:	County	Fraction	Section number	Township number	Range number
	Barton	NW1/4 NW1/4 NW1/4	28	T 18 S	R 13 E/W

2. Distance and direction from nearest town or city: 3 1/4 mi. South from Hoisington
Street address of well location if in city: KS.

3. Owner of well: H. C. Scott
R.R. or street: Hwy 281
City, state, zip code: Hoisington, KS.

4. Locate with "X" in section below:

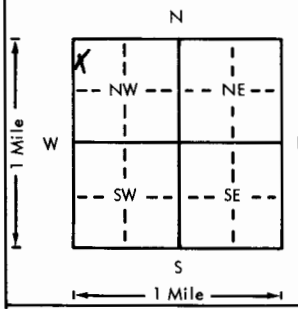

Sketch map:

6. Bore hole dia. 11 in. Completion date 9-27-77
Well depth 80 ft.

7. ___ Cable tool ___ Rotary ___ Driven ___ Dug
___ Hollow rod ___ Jetted ___ Bored ___ Reverse rotary

8. Use: ___ Domestic ___ Public supply ✓ Industry
___ Irrigation ___ Air conditioning ___ Stock
___ Lawn ___ Oil field water ___ Other

9. Casing: Material PVC Height: Above or ~~below~~
Threaded ___ Welded ___ Surface 18 in.
RMP ___ PVC ✓ Weight ___ lbs./ft.
Dia. 4 in. to 80 ft. depth Wall Thickness: inches or
Dia. ___ in. to ___ ft. depth gage No. 237

5. Type and color of material	From	To
Top soil	0	2
Broken clay & rock.	2	7
Clay	7	9
Broken rock & clay	9	11
Fire clay	11	16
Broken clay & rock.	16	20
Sand rock.	20	28
Fire clay	28	40
Sand rock.	40	43
Sand rock & shady light gray clay	43	46
Fire clay	46	52
Good Sand rock.	52	58
Light gray sandy shale & some sandrock	58	65
Sand Rock.	65	72
Blue gray sandy shale & some sandrock	72	80
(Use a second sheet if needed)		

BR →

10. Screen: Manufacturer's name Certain Feed
Type PVC Dia. 4
Slot/~~gauze~~ 11/16 Length 30
Set between 50 ft. and 80 ft.
___ ft. and ___ ft.
Gravel pack? ✓ Size range of material 1/2 3/4 3/8

11. Static water level: mo./day/yr.
33 ft. below land surface Date 9-27-77

12. Pumping level below land surfaces: N.A.
___ ft. after ___ hrs. pumping ___ g.p.m.
___ ft. after ___ hrs. pumping ___ g.p.m.
Estimated maximum yield ___ g.p.m.

13. Water sample submitted: mo./day/yr.
✓ Yes ___ No Date 9-27-77

14. Well head completion:
___ Pitless adapter ___ Inches above grade

15. Well grouted? ✓
With: ✓ Neat cement ___ Bentonite ___ Concrete
Depth: From 0 ft. to 10 ft.

16. Nearest source of possible contamination:
ft. 25 Direction SE Type Septic
Well disinfected upon completion? ___ Yes ___ No

17. Pump: ___ Not installed
Manufacturer's name ___
Model number ___ HP ___ Volts ___
Length of drop pipe ___ ft. capacity ___ g.p.m.
Type:
___ Submersible ___ Turbine
___ Jet ___ Reciprocating
___ Centrifugal ___ Other

18. Elevation:

Topography:
___ Hill
___ Slope
___ Upland
___ Valley

19. Remarks:

20. Water well contractor's certification:
This well was drilled under my jurisdiction and this report is true to the best of my knowledge and belief.
Rosencrantz-Bemis 134
Business name License No.
Address Great Bend, KS.
Signed Sandy Kilgore Date 10-3-77
Authorized representative

18 T 13 R (W) E 28 Sec NW 1/4 1/4 1/4

Forward the white, blue and pink copies to the Department of Health and Environment

Form WWC-5