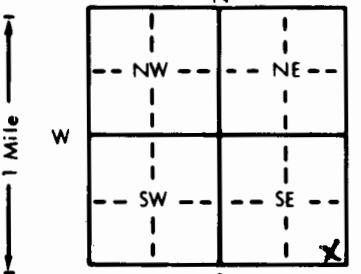


1 LOCATION OF WATER WELL:	Fraction	Section Number	Township Number	Range Number
County: <u>BARTON</u>	<u>SE 1/4 SE 1/4 SE 1/4</u>	<u>32</u>	T <u>18</u> S	R <u>13</u> E

Distance and direction from nearest town or city street address of well if located within city?

GREAT BEND 3 3/4 N 1/2 W NORTHSIDE FARM HOUSE

2 WATER WELL OWNER: <u>ARTHUR WONDRA</u>	Board of Agriculture, Division of Water Resources
RR#, St. Address, Box #: <u>RT 4</u>	Application Number:
City, State, ZIP Code: <u>GREAT BEND, KS</u>	

3 LOCATE WELL'S LOCATION WITH AN "X" IN SECTION BOX:	4 DEPTH OF COMPLETED WELL: <u>92</u> ft. ELEVATION:
	Depth(s) Groundwater Encountered 1. <u>4.6</u> ft. 2. <u>8.0</u> ft. 3. <u>5.24.83</u> ft.
	WELL'S STATIC WATER LEVEL <u>4.0</u> ft. below land surface measured on mo/day/yr
	Pump test data: Well water was <u>4.2</u> ft. after <u>7</u> hours pumping <u>30</u> gpm
	Est. Yield <u>30</u> gpm: Well water was <u>4.2</u> ft. after <u>7</u> hours pumping <u>30</u> gpm
	Bore Hole Diameter <u>7 7/8</u> in. to <u>9 1/2</u> ft., and <u>9 1/2</u> in. to <u>9 1/2</u> ft.
	WELL WATER TO BE USED AS:
	1 Domestic 3 Feedlot 6 Oil field water supply 9 Dewatering 12 Other (Specify below)
	2 Irrigation 4 Industrial 7 Lawn and garden only 10 Observation well
	Was a chemical/bacteriological sample submitted to Department? Yes <u>No</u> . If yes, mo/day/yr sample was submitted
	Water Well Disinfected? Yes <u>No</u>

5 TYPE OF BLANK CASING USED:	5 Wrought iron	8 Concrete tile	CASING JOINTS: Glued <u>X</u> Clamped
1 Steel	3 RMP (SR)	6 Asbestos-Cement	9 Other (specify below)
2 PVC	4 ABS	7 Fiberglass	10 Asbestos-cement
Blank casing diameter <u>5</u> in. to <u>8.2</u> ft., Dia			11 Other (specify)
Casing height above land surface <u>1.2</u> in., weight <u>2.65</u> lbs./ft. Wall thickness or gauge No. <u>214</u>			12 None used (open hole)
TYPE OF SCREEN OR PERFORATION MATERIAL:	7 PVC		
1 Steel	3 Stainless steel	5 Fiberglass	8 RMP (SR)
2 Brass	4 Galvanized steel	6 Concrete tile	9 ABS
SCREEN OR PERFORATION OPENINGS ARE: <u>1/8</u>	5 Gauzed wrapped	8 Saw cut	11 None (open hole)
1 Continuous slot	3 Mill slot	6 Wire wrapped	9 Drilled holes
2 Louvered shutter	4 Key punched	7 Torch cut	10 Other (specify)

6 GROUT MATERIAL:	1 Neat cement	2 Cement grout	3 Bentonite	4 Other
Grout Intervals: From <u>3</u> ft. to <u>1.0</u> ft., From <u>6.2</u> ft. to <u>7.2</u> ft., From <u>7.2</u> ft. to <u>7.2</u> ft.				
What is the nearest source of possible contamination:	1 Septic tank	4 Lateral lines	7 Pit privy	10 Livestock pens
	2 Sewer lines	5 Cess pool	8 Sewage lagoon	11 Fuel storage
	3 Watertight sewer lines	6 Seepage pit	9 Feedyard	12 Fertilizer storage
				13 Insecticide storage
Direction from well?				How many feet?

FROM	TO	LITHOLOGIC LOG	FROM	TO	LITHOLOGIC LOG
0	5	SOIL			
5	20	SANDY CLAY			
20	35	SAND			
35	46	CLAY			
46	55	GRAVEL			
55	80	CLAY			
80	92	SAND ROCK			

7 CONTRACTOR'S OR LANDOWNER'S CERTIFICATION: This water well was (1) constructed, (2) reconstructed, or (3) plugged under my jurisdiction and was completed on (mo/day/year) <u>5-24-87</u> and this record is true to the best of my knowledge and belief. Kansas Water Well Contractor's License No. <u>389</u> This Water Well Record was completed on (mo/day/yr) <u>5-24-87</u> under the business name of <u>REISER WATER WELL SERV INC.</u> by (signature) <u>Richard Reiser</u>
INSTRUCTIONS: Use typewriter or ball point pen, PLEASE PRESS FIRMLY and PRINT clearly. Please fill in blanks, underline or circle the correct answers. Send top three copies to Kansas Department of Health and Environment, Division of Environment, Environmental Geology Section, Topeka, KS 66620. Send one to WATER WELL OWNER and retain one for your records.