USE TYPEWRITER OR BALL POINT PEN-PRESS FIRMLY, PRINT CLEARLY.

WATER WELL RECORD
KSA 82a-1201-1215

Kansas Department of Health and Environment-Division of Environment
(Water well Contractors)
Topeka, Kansas 66620

1. Location of well:	County	Fraction	Section number	Township number	Range number
	Barton	NW1/4 SW1/4 SW1/4	32	T 18 S	R 13 W

2. Distance and direction from nearest town or city: 4N 1W
Street address of well location if in city: Great Bend, KS

3. Owner of well: GERALD Christen
R.R. or street: R1
City, state, zip code: Great Bend, KS

4. Locate with "X" in section below:

Sketch map:

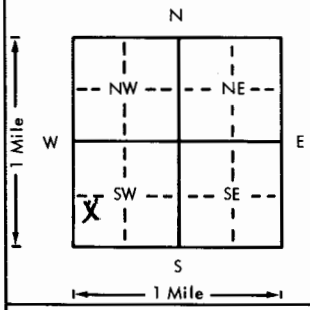

5. Type and color of material	From	To
TopSoil-Clay	0	35
Sand	35	45
Clay	45	70
Sand	70	95

(Use a second sheet if needed)

6. Bore hole dia. 9 in. Completion date
Well depth 95 ft. 10-20-76

7. __ Cable tool X Rotary __ Driven __ Dug
__ Hollow rod __ Jetted __ Bored __ Reverse rotary

8. Use: X Domestic __ Public supply __ Industry
__ Irrigation __ Air conditioning __ Stock
__ Lawn __ Oil field water __ Other

9. Casing: Material
Threaded __ Welded __
RMP PVC X
Dia. 5 in. to 95 ft. depth
Dia. in. to ft. depth
Height: Above or below
Surface 12 in.
Weight lbs./ft.
Wall Thickness: inches or gage No. Sch 40

10. Screen: Manufacturer's name NPI
Type PVC Dia. 5"
Slot/gauze 1/8" Length 20'
Set between 75 ft. and 95 ft.
ft. and ft.
Gravel pack? X Size range of material 3/8-3/4"

11. Static water level: mo./day/yr.
40 ft. below land surface Date 10-20-76

12. Pumping level below land surfaces:
ft. after hrs. pumping g.p.m.
ft. after hrs. pumping g.p.m.
Estimated maximum yield 40 g.p.m.

13. Water sample submitted: mo./day/yr.
__ Yes X No Date

14. Well head completion:
X Pitless adapter Inches above grade

15. Well grouted?
With: X Neat cement __ Bentonite __ Concrete
Depth: From 3 ft. to 13 ft.

16. Nearest source of possible contamination: Septic
ft. 60 Direction E Type ~~Tank~~
Well disinfected upon completion? X Yes No

17. Pump: X Not installed
Manufacturer's name
Model number HP Volts
Length of drop pipe ft. capacity g.p.m.
Type:
__ Submersible __ Turbine
__ Jet __ Reciprocating
__ Centrifugal __ Other

18. Elevation:
Topography:
__ Hill
__ Slope
__ Upland
X Valley

19. Remarks:

20. Water well contractor's certification:
This well was drilled under my jurisdiction and this report is true to the best of my knowledge and belief.
Kellys Water Well Ser. 186
Business name License No.
Address R2 Great Bend, KS
Signed Kelly Price Date 11-20
Authorized representative

T 18 R 13 E W Sec 32 1/4 NW 1/4 SW 1/4 SW 1/4

Forward the white, blue and pink copies to the Department of Health and Environment

Form WWC-5