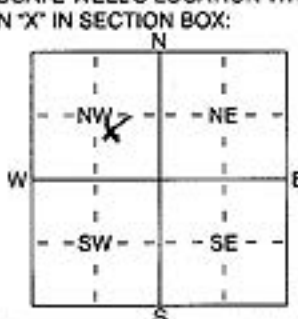


1 LOCATION OF WATER WELL: County: <u>Barton</u>	Fraction: <u>NW 1/4 SE 1/4 NW 1/4</u>	Section Number: <u>29</u>	Township Number: <u>T 18 S</u>	Range Number: <u>R 13 E</u>
--	---------------------------------------	---------------------------	--------------------------------	-----------------------------

Distance and direction from nearest town or city street address of well if located within city?

7 mi North of Great Bend 1/2 mi West South into2 WATER WELL OWNER: Joan StaudingerRR#, St. Address, Box #: 1209 Wilson
City, State, ZIP Code: Great Bend KS 67530Board of Agriculture, Division of Water Resources
Application Number:3 LOCATE WELL'S LOCATION WITH AN "X" IN SECTION BOX: 4 DEPTH OF COMPLETED WELL: 63 ft. ELEVATION:Depth(s) Groundwater Encountered 21 ft. 2 78 ft. 3 10-10-03 ft.WELL'S STATIC WATER LEVEL 21 ft. below land surface measured on mo/day/yr 10-10-03Pump test data: Well water was 80 ft. after 4 hours pumping 40 gpmEst. Yield 40 gpm: Well water was 80 ft. after 4 hours pumping 40 gpm

WELL WATER TO BE USED AS: 5 Public water supply 8 Air conditioning 11 Injection well

☒ Domestic 3 Feedlot 6 Oil field water supply 9 Dewatering 12 Other (Specify below)

2 Irrigation 4 Industrial 7 Domestic (lawn & garden) 10 Monitoring well

Was a chemical/bacteriological sample submitted to Department? Yes Yes No No: If yes, mo/day/yr sample was submittedWater Well Disinfected Yes No5 TYPE OF BLANK CASING USED: 5 Wrought iron 8 Concrete tile CASING JOINTS: Glued X Clamped

1 Steel 3 RMP (SR) 6 Asbestos-Cement 9 Other (specify below) Welded

☒ PVC 4 ABS 7 Fiberglass ThreadedBlank casing diameter 5 in. to 25 ft. Dia 5 in. to 25 ft. Dia 5 in. to 25 ft.Casing height above land surface 14 in., weight 50 lbs./ft. Wall thickness or gauge No. 50

TYPE OF SCREEN OR PERFORATION MATERIAL:

1 Steel 3 Stainless Steel 5 Fiberglass ☒ PVC 10 Asbestos-Cement

2 Brass 4 Galvanized Steel 6 Concrete tile 9 ABS 11 Other (Specify)

SCREEN OR PERFORATION OPENINGS ARE: 5 Gauzed wrapped 8 Saw cut 11 None (open hole)

1 Continuous slot ☒ Mill slot 6 Wire wrapped 9 Drilled holes2 Louvered shutter 4 Key punched 7 Torch cut 10 Other (specify) ft.SCREEN-PERFORATED INTERVALS: From 75 ft. to 85 ft. From 75 ft. to 85 ft.GRAVEL PACK INTERVALS: From 75 ft. to 85 ft. From 75 ft. to 85 ft.6 GROUT MATERIAL: 1 Neat cement 2 Cement grout ☒ Bentonite 4 OtherGrout intervals: From 70 ft. to 0 ft. From 70 ft. to 0 ft. From 70 ft. to 0 ft.

What is the nearest source of possible contamination:

1 Septic tank 4 Lateral lines 7 Pit privy 10 Livestock pens 14 Abandoned water well

2 Sewer lines 5 Cess pool 8 Sewage lagoon 11 Fuel storage 15 Oil well/Gas well

3 Watertight sewer lines 6 Seepage pit 9 Feedyard 12 Fertilizer storage 16 Other (specify below)

Direction from well? How many feet?

FROM TO LITHOLOGIC LOG FROM TO PLUGGING INTERVALS

0 1 Soil

1 55 Yellow clay

55 60 Red & white clay

60 78 White clay

78 81 White coarse sand

81 83 Red clay

7 CONTRACTOR'S OR LANDOWNER'S CERTIFICATION: This water well was (1) constructed, (2) reconstructed, or (3) plugged under my jurisdiction and was

completed on (mo/day/year) 10-8-03 and this record is true to the best of my knowledge and belief. KansasWater Well Contractor's Licence No. 660 This Water Well Record was completed on (mo/day/yr) 10-10-03under the business name of Goodman Water Well Drilling by (signature) Joan Staudinger