

1	LOCATION OF WATER WELL:	Fraction	Section Number			Township Number			Range Number		
	County: Barton	NE ¼ NE ¼ NW ¼	5			T 18 S			R 13 E/W		

Distance and direction from nearest town or city street address of well if located within city?

1577 Ninth St., Hoisington

2 WATER WELL OWNER: Kansas Dept. of Health & Environment T&M


RR#, St. Address, Box # : 1000 SW Jackson St., Suite 410

Board of Agriculture, Division of Water Resources

City, State, ZIP Code : Topeka, Kansas 66612-1367

Application Number:

3 LOCATE WELL'S LOCATION
WITH AN "X" IN SECTION BOX:

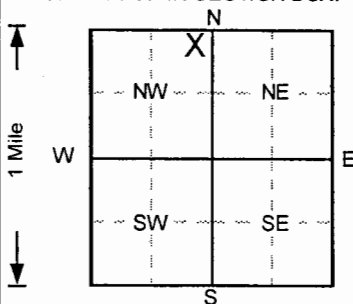

4 DEPTH OF COMPLETED WELL 20 ft. ELEVATION: 1832.43

Depth(s) Groundwater Encountered 1. ft. 2. ft. 3. ft.

WELL'S STATIC WATER LEVEL . . . 13.48 . . . ft. below land surface measured on mo/day/yr 2/9/2006.

Pump test data: Well water was **NA** ft. after hours pumping gpm

Est. Yield . . NA . . gpm: Well water was ft. after hours pumping gpm

Bore Hole Diameter . . . 8 . . . in. to . . . 20 . . . ft., and . . . in. to . . . ft.

WELL WATER TO BE USED AS: 5 Public water supply 8 Air conditioning 11 Injection well

1 Domestic 3 Feedlot 6 Oil field water supply 9 Dewatering 12 Other (Specify below)

2 Irrigation 4 Industrial 7 Lawn and garden only **10** Monitoring المراقبة

Was a chemical/bacteriological sample submitted to Department? Yes.....No ☒ ; If yes, mo/day/yr sample was submitted _____
Water Well Disinfected? Yes _____ No ☒

Water Well Disinfected? Yes No ☒

5	TYPE OF BLANK CASING USED:
---	----------------------------

- | | | | | |
|---------|------------|-------------------|-------------------------|---|
| 1 Steel | 3 RMP (SR) | 6 Asbestos-Cement | 9 Other (specify below) | Welded |
| 2 PVC | 4 ABS | 7 Fiberglass | | Threaded. ☒ |

Blank casing diameter 2 in. to 10 ft. Dia in. to ft. Dia in. to ft.

Casing height above land surface -3.12 in., weight lbs./ft. Wall thickness or gauge No. . . . Sch. 40.

TYPE OF SCREEN OR PERFORATION MATERIAL

- | | | | | |
|---------|--------------------|-----------------|------------|--------------------------|
| 1 Steel | 3 Stainless steel | 5 Fiberglass | 8 RMP (SR) | 11 Other (specify) |
| 2 Brass | 4 Galvanized steel | 6 Concrete tile | 9 ABS | 12 None used (open hole) |

SCREEN OR PERFORATION OPENINGS ARE:

- TEEN OR PERFORATION OPENINGS ARE:
- | | | | | |
|--------------------|--------------------|------------------|--------------------------|---------------------|
| 1 Continuous slot | 3 Mill slot | 5 Gauzed wrapped | 8 Saw cut | 11 None (open hole) |
| 2 Louvered shutter | 4 Key punched | 6 Wire wrapped | 9 Drilled holes | |
| | | 7 Torch cut | 10 Other (specify) | |

SCREEN-PERFORATED INTERVALS: From 10 ft. to 20 ft., From _____ ft. to _____ ft.

From ft. to ft., From ft. to ft.

GRAVEL PACK INTERVALS: From 8 ft. to 20 ft., From ft. to ft.

From ft. to ft., From ft. to ft.

6	GROUT MATERIAL:	1 Neat cement	2 Cement grout	3 Bentonite	4 Other Concrete
---	-----------------	---------------	----------------	-------------	------------------

Grout Intervals: From 0 ft to 1 ft, From 1 ft to 8 ft, From ft to ft.

What is the nearest source of possible contamination:

- | | | | | |
|--------------------------|-----------------|-----------------|------------------------|--------------------------|
| 1 Septic tank | 4 Lateral lines | 7 Pit privy | 11 Fuel storage | 15 Oil well/Gas well |
| 2 Sewer lines | 5 Cess pool | 8 Sewage lagoon | 12 Fertilizer storage | 16 Other (specify below) |
| 3 Watertight sewer lines | 6 Seepage pit | 9 Feedyard | 13 Insecticide storage | |

Direction from well?

How many feet?

[illegible]

7. CONTRACTOR'S OR LANDOWNER'S CERTIFICATION: This water well was (1) constructed, (2) reconstructed, or (3) plugged under my jurisdiction and was completed on (mo/day/year) 2/8/2006 and this record is true to the best of my knowledge and belief.

Kansas Water Well Contractor's License No. 527 This Water Well Record was completed on (mo/day/yr) 2/28/2006

under the business name of

GeoCore, Inc.

by (signature)

Done by: *[Signature]*