

WATER WELL PLUGGING RECORD Form WWC-5P
KSA 82a-1212
ID NO.
75912

1 LOCATION OF WATER WELL: County: Barton	Fraction SE ¼ SE ¼ NE ¼ ¼	Section Number 5	Township Number T 18 S	Range Number 13 ☐ E ☒ W
---	-------------------------------------	----------------------------	----------------------------------	--

Street/Rural Address of Well Location; if unknown, distance & direction from nearest town or intersection: If at owner's address, check here ☒ **202 N. Main**
Hoisington, KS

Global Positioning Systems (GPS) information:

Latitude: _____ (in decimal degrees)

Longitude: _____ (in decimal degrees)

Elevation: _____

Horizontal Datum: ☐ WGS84, ☐ NAD83, ☐ NAD27

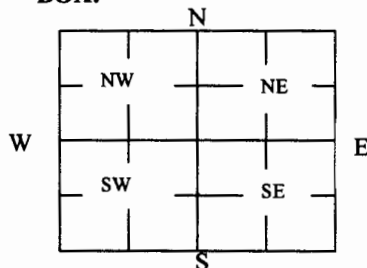
Collection Method: _____

2 WATER WELL OWNER: **Herb's Conoco**
RR#, St. Address, Box #: **202 N. Main St.**
City, State ZIP Code: **Hoisington, KS**

☐ GPS unit (Make/Model: _____)

☐ Digital Map/Photo, ☐ Topographic Map, ☐ Land Survey

Est. Accuracy: ☐ < 3 m, ☐ 3-5 m, ☐ 5-15 m, ☐ > 15 m

3 MARK WELL'S LOCATION WITH AN "X" IN SECTION BOX:

4 DEPTH OF WELL 32 ft.

WELL'S STATIC WATER LEVEL _____ ft

WELL WAS USED AS:

- ☐
- Domestic
-
- ☐
- Irrigation
-
- ☐
- Feedlot
-
- ☐
- Industrial

- ☐
- Public Water Supply
-
- ☐
- Oil Field Water Supply
-
- ☐
- Domestic (Lawn & Garden)
-
- ☐
- Air Conditioning

- ☐
- Dewatering
-
- ☒
- Monitoring
-
- ☐
- Injection Well
-
- ☐
- Other _____

Was a chemical/bacteriological sample submitted to Department? Yes ☐ No ☐
5 TYPE OF BLANK CASING USED:
☐ Steel
☒ PVC

☐ RMP (SR)
☐ ABS

☐ Wrought
☐ Asbestos-Cement

☐ Fiberglass
☐ Concrete Tile

☐ Other (Specify below) _____

Blank casing diameter 2 in. Was casing pulled? Yes ☒ No ☐ If yes, how much ~3 ft. below ground surface
Casing height above or below land surface _____ in.

6 GROUT PLUG MATERIAL: ☐ Neat cement ☐ Cement grout ☒ Bentonite ☐ Other _____

Grout Plug Intervals: From 3 ft. to 32 ft., From _____ ft. to _____ ft., From _____ ft. to _____ ft.

What is the nearest source of possible contamination:

- ☐
- Septic tank
-
- ☐
- Sewer lines
-
- ☐
- Watertight sewer lines
-
- ☐
- Lateral lines
-
- ☐
- Cess pool

- ☐
- Seepage pit
-
- ☐
- Pit privy
-
- ☐
- Sewage lagoon
-
- ☐
- Feedyard
-
- ☐
- Livestock pens

- ☐
- Fuel storage
-
- ☐
- Fertilizer storage
-
- ☐
- Insecticide storage
-
- ☐
- Abandoned water well
-
- ☐
- Oil well/Gas well

☐ Other (specify below) _____

Direction from well? _____

How many feet? _____

FROM	TO	PLUGGING MATERIALS	FROM	TO	PLUGGING MATERIALS
3	32	Bentonite			
					MW-5

7 CONTRACTOR'S OR LANDOWNER'S CERTIFICATION: This water well was plugged under my jurisdiction and was completed on (mo/day/year) 3/8/16 and this record is true to the best of my knowledge and belief. Kansas Water Well Contractor's License No. N/A. This Water Well Record was completed on (mo/day/year) 3/15/16 under the business name of GreenField Contractors, Inc. by (signature) Melissa D. McElhiney

Send one white copy to Kansas Department of Health & Environment, Geology Section, 1000 SW Jackson Street, Ste. 420, Topeka, KS 66612-1367. Send one copy to WATER WELL OWNER and retain one for your records.
Visit us at <http://www.kdheks.gov/waterwell/index.html> Telephone 785-296-5524.

KSA82a-1212
Revised 1/20/2015