


1 LOCATION OF WATER WELL:		Fraction	Section Number	Township Number		Range Number	
Distance and direction from nearest town or city street address, of well if located within city?							

Board of Agriculture, Division of Water Resources
Application Number: _____

4 DEPTH OF COMPLETED WELL: 102 ft. ELEVATION: _____

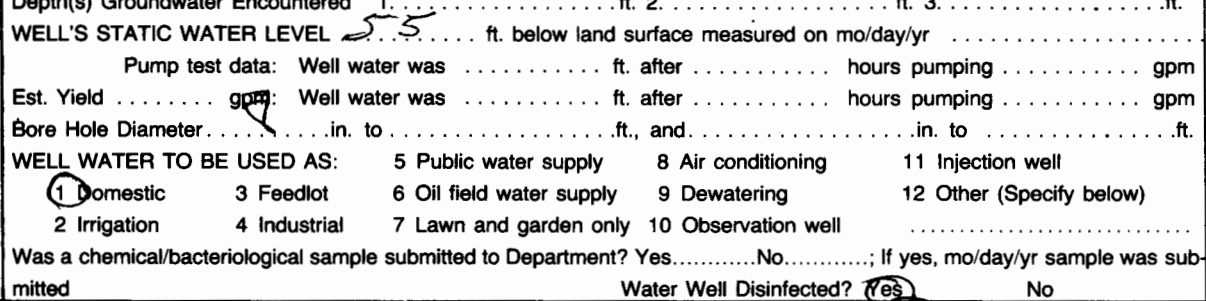

Blank casing diameter . . . 0 . . . in. to . . . 19 . . . ft. Dia . . . in. to . . . ft. Dia . . . in. to . . . ft.
Casing height above land surface . . . 12 . . . in., weight . . . lbs./ft. Wall thickness or gauge No.

SCREEN OR PERFORATION OPENINGS ARE:

1 Continuous slot	3 Mill slot	5 Gauzed wrapped	8 Saw cut	11 None (open hole)
2 Louvered shutter	4 Key punched	6 Wire wrapped	9 Drilled holes	
		7 Torch cut	10 Other (specify)	

SCREEN-PERFORATED INTERVALS:	From	10	ft. to	10 2	ft., From		ft. to		ft.
	From		ft. to		ft., From		ft. to		ft.
GRAVEL PACK INTERVALS:	From	13	ft. to	10 2	ft., From		ft. to		ft.
	From		ft. to		ft., From		ft. to		ft.

What is the nearest source of possible contamination: **NONE**

1 Septic tank	4 Lateral lines	7 Pit privy	10 Livestock pens	14 Abandoned water well
2 Sewer lines	5 Cess pool	8 Sewage lagoon	11 Fuel storage	15 Oil well/Gas well
3 Watertight sewer lines	6 Seepage pit	9 Feedyard	12 Fertilizer storage	16 Other (specify below)
			13 Insecticide storage	

[illegible][illegible]

7 CONTRACTOR'S OR LANDOWNER'S CERTIFICATION: This water well was (1) constructed, (2) reconstructed, or (3) plugged under my jurisdiction and was completed on (mo/day/year) Dec 1, 1986 and this record is true to the best of my knowledge and belief. 

INSTRUCTIONS: Use typewriter or ball point pen. PLEASE PRESS FIRMLY and PRINT clearly. Please fill in blanks, underline or circle the correct answers. Send top three copies to Kansas Department of Health and Environment, Office of Oil Field and Environmental Geology, Regulation and Permitting Section, Topeka, Kansas 66620-7500, Telephone: 913-862-9360. Send one to WATER WELL OWNER and retain one for your records.