USE TYPEWRITER OR BALL POINT PEN-PRESS FIRMLY, PRINT CLEARLY.

WATER WELL RECORD
KSA 82a-1201-1215

Kansas Department of Health and Environment-Division of Environment
(Water well Contractors)
Topeka, Kansas 66620

1. Location of well:	County	Fraction	Section number	Township number	Range number
	Barton	SW 1/4 NW 1/4 NE 1/4	28	T 18 S	R 14 E/W

2. Distance and direction from nearest town or city: 2n. 1E. ½W. of Heizer, Ks
Street address of well location if in city: ½n

3. Owner of well: Jeffrey Hammen
R.R. or street:
City, state, zip code: Albert, Ks. 6754

4. Locate with "X" in section below:

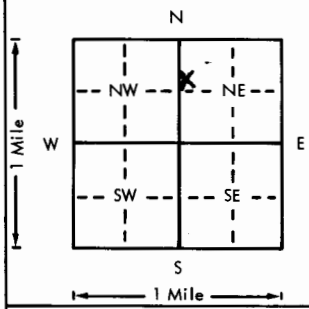

Sketch map:

6. Bore hole dia. 8 in. Completion date 5-9-77
Well depth 115 ft.

7. __ Cable tool X Rotary __ Driven __ Dug
__ Hollow rod __ Jetted __ Bored __ Reverse rotary

8. Use: __ Domestic __ Public supply __ Industry
X Irrigation __ Air conditioning __ Stock
__ Lawn __ Oil field water __ Other

9. Casing: Material Steel Height: Above or ~~below~~
Threaded ___ Welded X Surface 18 in.
RMP ___ PVC ___ Weight ___ lbs./ft.
Dia. 16 in. to 115 ft. depth Wall Thickness: inches or
Dia. ___ in. to ___ ft. depth gage No. 790

10. Screen: Manufacturer's name Johnson Douro
Type Steel Dia. 16
Slot/gauze 3/16" Length 26'
Set between 89 ft. and 115 ft.
___ ft. and ___ ft.
Gravel pack? yes Size range of material 3/4 3/8

11. Static water level: mo./day/yr.
26 ft. below land surface Date 10-25-76

12. Pumping level below land surfaces:
70 ft. after 1 hrs. pumping 200 g.p.m.
___ ft. after ___ hrs. pumping ___ g.p.m.
Estimated maximum yield 400 g.p.m.

13. Water sample submitted: mo./day/yr.
X Yes ___ No Date 10-25-76

14. Well head completion:
___ Pitless adapter ___ Inches above grade

15. Well grouted? yes
With: ___ Neat cement ___ Bentonite X Concrete
Depth: From 0 ft. to 10 ft.

16. Nearest source of possible contamination:
ft. 1 mi. Direction W Type septic tank
Well disinfected upon completion? ✓ Yes ___ No

17. Pump: Not installed
Manufacturer's name W.L.R.
Model number 4-10CM HP .25 Volts 440
Length of drop pipe 105 ft. capacity 400 g.p.m.
Type:
___ Submersible X Turbine
___ Jet ___ Reciprocating
___ Centrifugal ___ Other

5. Type and color of material	From	To
Top soil	0	3
Hard clay	3	18
Soft sandy clay	18	47
Hard clay	47	97
Sand and clay	97	100
Good sand and gravel	100	120
BR ≥ 120		

(Use a second sheet if needed)

18. Elevation:

19. Remarks:

Topography:
___ Hill
___ Slope
X Upland
___ Valley

20. Water well contractor's certification:
This well was drilled under my jurisdiction and this report is true to the best of my knowledge and belief.
Business name Rosencrantz-Bemis 134 License No.
Address Great Bend, Ks 67530
Signed Sandy Kilgore Date 5-19-77
Authorized representative

T 18 R 14 (W) E Sec 28 1/4 1/4 1/4 1/4 Sunnine

Forward the white, blue and pink copies to the Department of Health and Environment

Form WWC-5