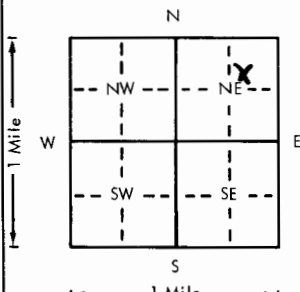


USE TYPEWRITER OR BALL
POINT PEN-PRESS FIRMLY,
PRINT CLEARLY.

WATER WELL RECORD
KSA 82a-1201-1215

Kansas Department of Health and
Environment-Division of Environment
(Water well Contractors)
Topeka, Kansas 66620

1. Location of well:		County Barton	Fraction SW 1/4 NE 1/4 NE 1/4	Section number 32	Township number T 18 S R 14 E 10	Range number 14
2. Distance and direction from nearest town or city: 2-N 1-W of Heizer, KS. Street address of well location if in city:				3. Owner of well: Larry meeks R.R. or street: Box 115 City, state, zip code: Olmitz, Kans. 67564		
4. Locate with "X" in section below:		Sketch map:		6. Bore hole dia. 11 in. Completion date Well depth 120 ft. 10-4-78		
				7. ☒ Cable tool ☒ Rotary ☐ Driven ☐ Dug ☐ Hollow rod ☐ Jetted ☐ Bored ☐ Reverse rotary		
5. Type and color of material		From		To		8. Use: ☒ Domestic ☐ Public supply ☐ Industry ☐ Irrigation ☐ Air conditioning ☐ Stock ☐ Lawn ☐ Oil field water ☐ Other
fill sand		0		1 1/2		9. Casing: Material PVC Height: Above or below Threaded ☐ Welded ☒ Surface 18 in. RMP ☐ PVC ☒ Weight ☐ lbs./ft. Dia 5 1/2 in. to 120 ft. depth Wall Thickness: inches or Dia. ☐ in. to ☐ ft. depth gage No. 258
hard clay		1 1/2		28		10. Screens: Manufacturer's name Certa Tees Type PVC Dia. ☐ Slot/gauze 1/16 Length 20 Set between 110 ft. and 120 ft. ☐ ft. and ☐ ft. Gravel pack? ☒ Size range of material 2 1/2 to 4 1/2
soft sandy clay		28		80		11. Static water level: ☐ mo./day/yr. 28 ft. below land surface Date 10-4-78
sand		80		95		12. Pumping level below land surfaces: 28 ft. after 1 hrs. pumping 40 g.p.m. ☐ ft. after ☐ hrs. pumping ☐ g.p.m. Estimated maximum yield 200 g.p.m.
clay		95		99		13. Water sample submitted: ☐ mo./day/yr. ☒ Yes ☐ No Date 10-4-78
sand & gravel		99		118		14. Well head completion: ☐ Pitless adapter ☐ Inches above grade
clay		118		120		15. Well grouted? ☒ With: ☒ Neat cement ☐ Bentonite ☐ Concrete Depth: From 0 ft. to 20 ft.
BR = 118'						16. Nearest source of possible contamination: ft. 300 Direction NW Type septic Well disinfected upon completion? HTH Yes ☐ No ☐
						17. Pump: ☒ Not installed Manufacturer's name ☐ Model number ☐ HP ☐ Volts ☐ Length of drop pipe ☐ ft. capacity ☐ g.p.m. Type: ☐ Submersible ☐ Turbine ☐ Jet ☐ Reciprocating ☐ Centrifugal ☐ Other
18. Elevation:		19. Remarks:		20. Water well contractor's certification: This well was drilled under my jurisdiction and this report is true to the best of my knowledge and belief. Rosecrantz-Bemis 134 Business name License No. 67530 Address Great Bend, KS Signed Sandy Kulp Date 10-19-78 Authorized representative		