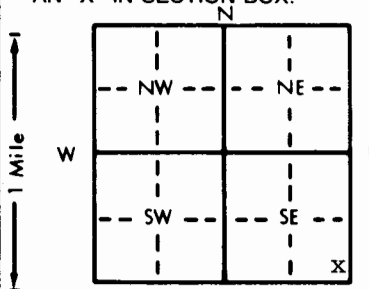


1 LOCATION OF WATER WELL:	Fraction	Section Number	Township Number	Range Number
County: Barton	SE ¼ SE ¼ SE ¼	35	T 18 S	R 14 EW

Distance and direction from nearest town or city street address of well if located within city?

Approximately 3 miles east and ½ mile north of Heizer, Kansas

2 WATER WELL OWNER:	USD #428	Board of Agriculture, Division of Water Resources Application Number:
RR#, St. Address, Box # :	201 Patton Road	
City, State, ZIP Code :	Great Bend, Kansas 67530	

3 LOCATE WELL'S LOCATION WITH AN "X" IN SECTION BOX:	4 DEPTH OF COMPLETED WELL: 115 ft. ELEVATION: unknown
	Depth(s) Groundwater Encountered 1. 51 ft. 2. ft. 3. ft.
	WELL'S STATIC WATER LEVEL 51 ft. below land surface measured on mo/day/yr
	Pump test data: Well water was not ch'd. ft. after hours pumping gpm
	Est. Yield unknown gpm: Well water was ft. after hours pumping gpm
	Bore Hole Diameter 9 in. to 115 ft., and in. to ft.
WELL WATER TO BE USED AS:	5 Public water supply 8 Air conditioning 11 Injection well
1 Domestic 3 Feedlot 6 Oil field water supply 9 Dewatering 12 Other (Specify below)	
2 Irrigation 4 Industrial 7 Lawn and garden only 10 Monitoring well	
Was a chemical/bacteriological sample submitted to Department? Yes No; If yes, mo/day/yr sample was submitted	Water Well Disinfected? Yes No x

5 TYPE OF BLANK CASING USED:	5 Wrought iron 8 Concrete tile CASING JOINTS: Glued x Clamped
1 Steel 3 RMP (SR) 6 Asbestos-Cement 9 Other (specify below) Welded	
2 PVC 4 ABS 7 Fiberglass Threaded	
Blank casing diameter 5 in. to 96 ft., Dia 5 in. to 113 ft., Dia in. to ft.	
Casing height above land surface 24 in., weight 2.36 lbs./ft. Wall thickness or gauge No. 214	
TYPE OF SCREEN OR PERFORATION MATERIAL:	7 PVC 10 Asbestos-cement
1 Steel 3 Stainless steel 5 Fiberglass 8 RMP (SR) 11 Other (specify)	
2 Brass 4 Galvanized steel 6 Concrete tile 9 ABS 12 None used (open hole)	
SCREEN OR PERFORATION OPENINGS ARE:	5 Gauzed wrapped 8 Saw cut 11 None (open hole)
1 Continuous slot 3 Mill slot 6 Wire wrapped 9 Drilled holes	
2 Louvered shutter 4 Key punched 7 Torch cut 10 Other (specify)	
SCREEN-PERFORATED INTERVALS: From 96 ft. to 111 ft., From ft. to ft.	
GRAVEL PACK INTERVALS: From 90 ft. to 113 ft., From ft. to ft.	
From 20 ft. to 85 ft., From ft. to ft.	

6 GROUT MATERIAL:	1 Neat cement 2 Cement grout 3 Bentonite 4 Other Bentonite Hole Plug
Grout intervals: From 4 ft. to 20 ft., From ft. to ft., From 85 ft. to 90 ft.	
What is the nearest source of possible contamination:	10 Livestock pens 14 Abandoned water well
1 Septic tank 4 Lateral lines 7 Pit privy 11 Fuel storage 15 Oil well/Gas well	
2 Sewer lines 5 Cess pool 8 Sewage lagoon 12 Fertilizer storage 16 Other (specify below)	
3 Watertight sewer lines 6 Seepage pit 9 Feedyard 13 Insecticide storage	
Direction from well? northeast	How many feet? 100'

FROM	TO	LITHOLOGIC LOG	FROM	TO	PLUGGING INTERVALS
0	53	Topsoil and Clay, brown, soft			* WILL BE SUBMITTING WATER SAMPLES PLANS APPLICATION FOR NON COMMUNITY PUBLIC SUPPLY WELL
53	68	Sand and Gravel, fine to medium			
68	79	Clay, black, soft			
79	85	Sand and Gravel, fine to medium, with a lot of clay, black streaks			
85	93	Clay, tan, soft			
93	115	Sand and Gravel, fine to medium, with medium to fine limestone and sandstone cobble			
115		Clay, red and gray Dakota			

7 CONTRACTOR'S OR LANDOWNER'S CERTIFICATION: This water well was (1) constructed, (2) reconstructed, or (3) plugged under my jurisdiction and was completed on (mo/day/year) 11-7-89 and this record is true to the best of my knowledge and belief. Kansas Water Well Contractor's License No. 185. This Water Well Record was completed on (mo/day/yr) 11-20-89 under the business name of Clarke Well & Equipment, Inc. by (signature) Paul W. Clarke
--