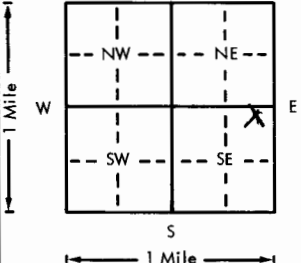


USE TYPEWRITER OR BALL  
POINT PEN-PRESS FIRMLY,  
PRINT CLEARLY.

WATER WELL RECORD  
KSA 82a-1201-1215

Kansas Department of Health and  
Environment-Division of Environment  
(Water well Contractors)  
Topeka, Kansas 66620

|   |  |                         |                                         |   |                                |                               |
|---|--|-------------------------|-----------------------------------------|---|--------------------------------|-------------------------------|
| 1. Location of well:   |  | County<br><u>Barton</u> | Fraction<br><u>NE 1/4 NE 1/4 SE 1/4</u> | Section number<br><u>35</u>   | Township number<br><u>18</u> S | Range number<br><u>14</u> E/W |
| 2. Distance and direction from nearest town or city:<br><u>4 P - 3 W 1/4 N of Gr. B-1</u><br>Street address of well location if in city:                        |  |                         |                                         | 3. Owner of well: <u>Keith Hammeke</u><br>R.R. or street: <u>Rt 3</u><br>City, state, zip code: <u>Great Bend, KS</u>   |                                |                               |
| 4. Locate with "X" in section below:   |  | Sketch map:             |                                         | 6. Bore hole dia. <u>29</u> in. Completion date <u>5-11-76</u><br>Well depth <u>128</u> ft.   |                                |                               |
|                                                                                 |  |                         |                                         | 7. <input type="checkbox"/> Cable tool <input checked="" type="checkbox"/> Rotary <input type="checkbox"/> Driven <input type="checkbox"/> Dug<br><input type="checkbox"/> Hollow rod <input type="checkbox"/> Jetted <input type="checkbox"/> Bored <input type="checkbox"/> Reverse rotary |                                |                               |
| 5. Type and color of material   |  |                         |                                         | From   | To                             |                               |
| <u>Sandy Top Soil</u>   |  |                         |                                         | <u>0</u>   | <u>1</u>                       |                               |
| <u>Clay</u>   |  |                         |                                         | <u>1</u>   | <u>24</u>                      |                               |
| <u>Mealey Clay</u>   |  |                         |                                         | <u>24</u>   | <u>50</u>                      |                               |
| <u>Clay</u>   |  |                         |                                         | <u>50</u>   | <u>61</u>                      |                               |
| <u>Soft Sandy Clay</u>   |  |                         |                                         | <u>61</u>   | <u>70</u>                      |                               |
| <u>Clay</u> <u>13.2 ft</u> <u>2 ft</u> <u>8 ft</u>   |  |                         |                                         | <u>70</u>   | <u>79</u>                      |                               |
| <u>Fine Sand</u> <u>13.2 ft</u>   |  |                         |                                         | <u>79</u>   | <u>82</u>                      |                               |
| <u>Rock</u> <u>13.2 ft</u> <u>2 ft</u> <u>8 ft</u>   |  |                         |                                         | <u>82</u>   | <u>85</u>                      |                               |
| <u>Hard Brown Clay</u> <u>13.2 ft</u> <u>2 ft</u> <u>8 ft</u>                                                                                                   |  |                         |                                         | <u>85</u>   | <u>97</u>                      |                               |
| <u>Sand</u> <u>13.2 ft</u> <u>2 ft</u> <u>8 ft</u>   |  |                         |                                         | <u>97</u>   | <u>102</u>                     |                               |
| <u>Clay</u> <u>13.2 ft</u> <u>2 ft</u> <u>8 ft</u>   |  |                         |                                         | <u>102</u>   | <u>103</u>                     |                               |
| <u>Good Sand</u>   |  |                         |                                         | <u>103</u>   | <u>111</u>                     |                               |
| <u>Clay</u>   |  |                         |                                         | <u>111</u>   | <u>113</u>                     |                               |
| <u>Good Sand</u>   |  |                         |                                         | <u>113</u>   | <u>121</u>                     |                               |
| <u>Clay</u>   |  |                         |                                         | <u>121</u>   | <u>121 1/2</u>                 |                               |
| <u>Good Gravel</u> (Use a second sheet if needed)   |  |                         |                                         | <u>121 1/2</u>   | <u>125</u>                     |                               |
| 18. Elevation:   |  | 19. Remarks:            |                                         | 20. Water well contractor's certification:   |                                |                               |
| <u>Fire Clay</u>   |  | <u>PR 125' fm</u>       |                                         | This well was drilled under my jurisdiction and this report is true to the best of my knowledge and belief.   |                                |                               |
| Topography:<br><input type="checkbox"/> Hill<br><input type="checkbox"/> Slope<br><input checked="" type="checkbox"/> Upland<br><input type="checkbox"/> Valley |  | <u>1892</u>             |                                         | Business name <u>Rosenkrantz-Bemis</u> License No. <u>134</u><br>Address <u>Great Bend, KS</u><br>Signed <u>Freddie Radson</u> Date <u>9/27/76</u><br>Authorized representative   |                                |                               |

Forward the white, blue and pink copies to the Department of Health and Environment

Form WWC-5