


1 LOCATION OF WATER WELL: County: <u>Barton</u>	Fraction <u>SE</u> $\frac{1}{4}$ <u>SW</u> $\frac{1}{4}$ <u>SE</u> $\frac{1}{4}$	Section Number <u>2</u>	Township Number T <u>18</u> S	Range Number R <u>14</u> E <u>0</u>
--	---	----------------------------	----------------------------------	--

Distance and direction from nearest town or city street address of well if located within city?

2 WATER WELL OWNER: William & Delphine HickeyRR#, St. Address, Box # : 328 NW 100 RD
City, State, ZIP Code : Hickman, Mo. 64544Board of Agriculture, Division of Water Resources
Application Number:3 LOCATE WELL'S LOCATION WITH 4 DEPTH OF COMPLETED WELL 130 ft. ELEVATION:

AN "X" IN SECTION BOX:

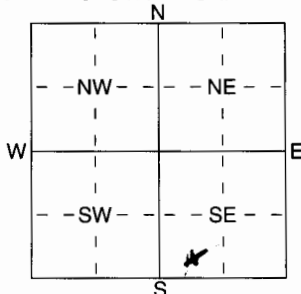

Depth(s) Groundwater Encountered 1 122 to 126 ft. 2 ft. 3 ft.
 WELL'S STATIC WATER LEVEL 6.0 ft. below land surface measured on mo/day/yr 1-30-06
 Pump test data: Well water was 130 ft. after 4 hours pumping 25 gpm
 Est. Yield 25 gpm: Well water was ft. after hours pumping gpm
 WELL WATER TO BE USED AS: 5 Public water supply 8 Air conditioning 11 Injection well
~~X~~ Domestic 3 Feedlot 6 Oil field water supply 9 Dewatering 12 Other (Specify below)
 2 Irrigation 4 Industrial 7 Domestic (lawn & garden) 10 Monitoring well

Was a chemical/bacteriological sample submitted to Department? Yes No; If yes, mo/day/yr sample was submitted
Water Well Disinfected? Yes No

5 TYPE OF BLANK CASING USED:

1 Steel 3 RMP (SR)
~~X~~ PVC 4 ABS5 Wrought iron 8 Concrete tile
6 Asbestos-Cement 9 Other (specify below)
7 FiberglassCASING JOINTS: Glued ~~X~~ Clamped
Welded
ThreadedBlank casing diameter 5 in. to 110 ft. Dia in. to ft. Dia in. to ft.Casing height above land surface 14 in. weight 500 lbs./ft. Wall thickness or gauge No. 50

TYPE OF SCREEN OR PERFORATION MATERIAL:

1 Steel 3 Stainless Steel
2 Brass 4 Galvanized Steel5 Fiberglass 8 RMP (SR)
6 Concrete tile 9 ABS~~X~~ PVC 10 Asbestos-Cement
11 Other (Specify)
12 None used (open hole)

SCREEN OR PERFORATION OPENINGS ARE:

1 Continuous slot ~~X~~ Mill slot
2 Louvered shutter 4 Key punched5 Gauzed wrapped
6 Wire wrapped
7 Torch cut8 Saw cut 11 None (open hole)
9 Drilled holes
10 Other (specify) ft.SCREEN-PERFORATED INTERVALS: From 130 ft. to 110 ft. From ft. to ft.GRAVEL PACK INTERVALS: From 130 ft. to 100 ft. From ft. to ft.6 GROUT MATERIAL: 1 Neat cement 2 Cement grout ~~X~~ Bentonite 4 OtherGrout Intervals: From 100 ft. to 80 ft. From 40 ft. to 0 ft. From ft. to ft.

What is the nearest source of possible contamination:

1 Septic tank 4 Lateral lines
~~X~~ Sewer lines 5 Cess pool
3 Watertight sewer lines 6 Seepage pit7 Pit privy
8 Sewage lagoon
9 Feedyard10 Livestock pens 14 Abandoned water well
11 Fuel storage 15 Oil well/Gas well
12 Fertilizer storage 16 Other (specify below)
13 Insecticide storageDirection from well? EastHow many feet? 250'

FROM	TO	LITHOLOGIC LOG	FROM	TO	PLUGGING INTERVALS
0	3	Soil			
3	30	Yellow clay			
30	35	Blue & Red clay			
35	45	White shale			
45	55	Red & Blue shale			
55	60	Blue & White sandy shale			
60	70	Blue shale			
70	80	Blue & White sandy shale			
80	100	Blue shale			
100	122	Blue & White sandy shale			
122	126	med to coarse sand white			
126	130	Red shale			

7 CONTRACTOR'S OR LANDOWNER'S CERTIFICATION: This water well was ~~X~~ constructed, (2) reconstructed, or (3) plugged under my jurisdiction and was completed on (mo/day/year) 1-30-06 and this record is true to the best of my knowledge and belief. Kansas Water Well Contractor's Licence No 660 This Water Well Record was completed on (mo/day/yr) 1-30-06 under the business name of Goodman water well only by (signature) John Smith