


WATER WELL RECORD Form WWC-5

Division of Water Resources App. No. **20160141** Well ID

Original Record Correction Change in Well Use

1 LOCATION OF WATER WELL: Fraction $\frac{1}{4}$ SW $\frac{1}{4}$ NE $\frac{1}{4}$ SW $\frac{1}{4}$ Section Number **27** Township Number **T 18 S** Range Number **R 14** E W
County: **Barton**

2 WELL OWNER: Last Name: **L D Drilling** First: **Street or Rural Address where well is located (if unknown, distance and direction from nearest town or intersection):** If at owner's address, check here:
Business: **L D Drilling**
Address: **7 SW 26 Avenue**
Address:
City: **Great Bend** State: **KS** ZIP: **67530**
1 3/4 North, 1 1/4 East of Heizer

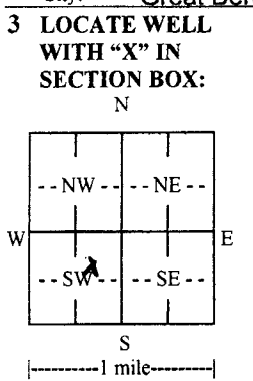

4 DEPTH OF COMPLETED WELL: **120** ft.
Depth(s) Groundwater Encountered: 1) ft.
2) ft. 3) ft., or 4) Dry Well
WELL'S STATIC WATER LEVEL: **38** ft.
 below land surface, measured on (mo-day-yr) **9-14-16**
 above land surface, measured on (mo-day-yr)
Pump test data: Well water was ft.
after hours pumping gpm
Well water was ft.
after hours pumping gpm
Estimated Yield: gpm
Bore Hole Diameter: **10** in. to **120** ft. and
..... in. to ft.

5 Latitude: **38.452767** (decimal degrees)
Longitude: **98.861505** (decimal degrees)
Horizontal Datum: WGS 84 NAD 83 NAD 27
Source for Latitude/Longitude:
 GPS (unit make/model:)
(WAAS enabled? Yes No)
 Land Survey Topographic Map
 Online Mapper:

6 Elevation: ft. Ground Level TOC
Source: Land Survey GPS Topographic Map
 Other

7 WELL WATER TO BE USED AS:

1. Domestic: <input type="checkbox"/> Household <input type="checkbox"/> Lawn & Garden <input type="checkbox"/> Livestock	2. <input type="checkbox"/> Irrigation	3. <input type="checkbox"/> Feedlot	4. <input type="checkbox"/> Industrial	5. <input type="checkbox"/> Public Water Supply: well ID	6. <input type="checkbox"/> Dewatering: how many wells?	7. <input type="checkbox"/> Aquifer Recharge: well ID	8. <input type="checkbox"/> Monitoring: well ID	9. Environmental Remediation: well ID	<input type="checkbox"/> Air Sparge <input type="checkbox"/> Soil Vapor Extraction <input type="checkbox"/> Recovery <input type="checkbox"/> Injection	10. <input checked="" type="checkbox"/> Oil Field Water Supply: lease Mauler Trust	11. Test Hole: well ID	12. Geothermal: how many bores?	a) Closed Loop <input type="checkbox"/> Horizontal <input type="checkbox"/> Vertical b) Open Loop <input type="checkbox"/> Surface Discharge <input type="checkbox"/> Inj. of Water	13. <input type="checkbox"/> Other (specify):
--	--	-------------------------------------	--	--	---	---	---	---	--	---	------------------------------	---------------------------------------	--	---

Was a chemical/bacteriological sample submitted to KDHE? Yes No If yes, date sample was submitted:

Water well disinfected? Yes No

8 TYPE OF CASING USED: Steel PVC Other CASING JOINTS: Glued Clamped Welded Threaded
Casing diameter **5** in. to **120** ft., Diameter in. to ft., Diameter in. to ft.
Casing height above land surface **18** in. Weight **SDR-26** lbs./ft. Wall thickness or gauge No.

TYPE OF SCREEN OR PERFORATION MATERIAL:
 Steel Stainless Steel Fiberglass PVC Other (Specify)
 Brass Galvanized Steel Concrete tile None used (open hole)

SCREEN OR PERFORATION OPENINGS ARE:
 Continuous Slot Mill Slot Gauze Wrapped Torch Cut Drilled Holes Other (Specify)
 Louvered Shutter Key Punched Wire Wrapped Saw Cut None (Open Hole)

SCREEN-PERFORATED INTERVALS: From **120** ft. to **100** ft., From ft. to ft., From ft. to ft.
GRAVEL PACK INTERVALS: From **120** ft. to **20** ft., From ft. to ft., From ft. to ft.

9 GROUT MATERIAL: Neat cement Cement grout Bentonite Other
Grout Intervals: From ft. to ft., From **20** ft. to **0** ft., From ft. to ft.

Nearest source of possible contamination:
 Septic Tank Lateral Lines Pit Privy Livestock Pens Insecticide Storage
 Sewer Lines Cess Pool Sewage Lagoon Fuel Storage Abandoned Water Well
 Watertight Sewer Lines Seepage Pit Feedyard Fertilizer Storage Oil Well/Gas Well
 Other (Specify) **None**

Direction from well? Distance from well? ft.

10 FROM	TO	LITHOLOGIC LOG	FROM	TO	LITHO. LOG (cont.) or PLUGGING INTERVALS
	3	Top soil			
	8	Brown clay			
	23	Hard sticky, gray clay			
	45	Tan & yellow clay			
	97	Tan clay w/ caliche streaks			
	120	Sand & gravel- small med coarse			

Notes:

11 CONTRACTOR'S OR LANDOWNER'S CERTIFICATION: This water well was constructed, reconstructed, or plugged under my jurisdiction and was completed on (mo-day-year) **9-14-16** and this record is true to the best of my knowledge and belief. Kansas Water Well Contractor's License No. **134** This Water Well Record was completed on (mo-day-year) **9-16-16** under the business name of **Rosenkrantz- Bemis Ent. Inc.** Signature **Thora A. Bemis**



ASSIGNMENT OF WATER WELL TO LANDOWNER

I, Gerald Mauler of 677 W Barton Co. Rd.
(Landowner's address)

Great Bend Kansas 67530 am the landowner on which a water well is located in the
(City) (State)

SW quarter of the SW quarter of the NE quarter of the SW quarter of Section 27,
Township 18 S, Range 14 E, in Barton County, Kansas which is approximately
1650 feet north/south, and 3630 feet east/west of the apparent SE section corner.

The water well was drilled in 9/16 (month/year).

I hereby request that L D Drilling, Inc. leave the water well,
(Well operator/owner name)

which was drilled under Temporary/Term Water Permit # 20160141, unplugged, and I will
assume all responsibility for the plugging of said water well in accordance with the requirements of the
Kansas Department of Health and Environment regulation K.A.R. 28-30-7.

LANDOWNER:

Gerald E Mauler 10-12-16
(Signature) (Date)

GERALD E MAULER
(Print)

WELL OWNER:

Susan Schneweis 10-7-2016
(Signature) (Date)

By: Susan Schneweis
(Agent) L D Drilling, Inc.

IF ADDITIONAL LANDOWNER

Lois A. Mauler 10-12-16
(Signature) (Date)

Lois A. Mauler
(Print)

RECEIVED
OCT 17 2016
BUREAU OF WATER