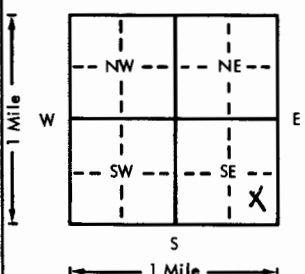


USE TYPEWRITER OR BALL
POINT PEN-PRESS FIRMLY,
PRINT CLEARLY.

WATER WELL RECORD
KSA 82a-1201-1215

Kansas Department of Health and
Environment-Division of Environment
(Water well Contractors)
Topeka, Kansas 66620

1. Location of well:		County <u>Barton</u>	Fraction <u>1/4 SE 1/4 SE 1/4</u>	Section number <u>25</u>	Township number T <u>18</u> S R <u>15</u> <u>NW</u>
2. Distance and direction from nearest town or city: Street address of well location if in city:			3. Owner of well: R.R. or street: City, state, zip code:		
<u>5 E.</u> <u>Albert, KS</u>			<u>Raymond Schneider</u> <u>01mitz, KS</u>		
4. Locate with "X" in section below:		Sketch map:			
					
5. Type and color of material		From	To	6. Bore hole dia. <u>8</u> in. Completion date <u>8-7-76</u> Well depth <u>56</u> ft.	
<u>Top Soil - clay</u>		<u>0</u>	<u>22</u>	7. ☒ Cable tool ☒ Rotary ☐ Driven ☐ Dug ☐ Hollow rod ☐ Jetted ☐ Bored ☐ Reverse rotary	
<u>Sand</u>		<u>22</u>	<u>30</u>	8. Use: ☒ Domestic ☐ Public supply ☐ Industry ☐ Irrigation ☐ Air conditioning ☐ Stock ☐ Lawn ☐ Oil field water ☐ Other	
<u>Sand - Gravel</u>		<u>30</u>	<u>56</u>	9. Casing: Material <u>PVC</u> Height: <u>Above</u> or below Threaded ☐ Welded ☒ Surface <u>12</u> in. RMP ☐ PVC ☒ Weight <u>12</u> lbs./ft. Dia. <u>5</u> in. to <u>56</u> ft. depth Wall Thickness: inches or Dia. <u>5</u> in. to <u>56</u> ft. depth gage No. <u>Sch 40</u>	
				10. Screen: Manufacturer's name <u>MPI</u> Type <u>PVC</u> Dia. <u>5"</u> Slot/gauze <u>1/8</u> Length <u>20'</u> Set between <u>36</u> ft. and <u>56</u> ft. ft. and <u>56</u> ft. Gravel pack? ☒ Size range of material <u>1/8-3/4</u>	
				11. Static water level: <u>27</u> ft. below land surface Date <u>8-7-76</u> mo./day/yr.	
				12. Pumping level below land surfaces: ft. after <u>1</u> hrs. pumping <u>30</u> g.p.m. ft. after <u>1</u> hrs. pumping <u>30</u> g.p.m. Estimated maximum yield <u>30</u> g.p.m.	
				13. Water sample submitted: <u>Yes</u> ☒ No ☐ Date <u>8-7-76</u> mo./day/yr.	
				14. Well head completion: ☐ Pitless adapter <u>12</u> inches above grade	
				15. Well grouted? ☒ With: ☒ Neat cement ☐ Bentonite ☐ Concrete Depth: From <u>0</u> ft. to <u>10</u> ft.	
				16. Nearest source of possible contamination: <u>Live</u> ft. <u>110</u> Direction <u>N</u> Type <u>Stock</u> Well disinfected upon completion? ☒ Yes ☐ No	
				17. Pump: ☒ Not installed Manufacturer's name <u>Kellys Water Well Ser. 186</u> Model number <u>R2</u> HP <u>2</u> Volts <u>115</u> Length of drop pipe <u>25</u> ft. capacity <u>25</u> g.p.m. Type: ☐ Submersible ☐ Turbine ☐ Jet ☐ Reciprocating ☐ Centrifugal ☐ Other	
18. Elevation:		19. Remarks:			
Topography: ☐ Hill ☐ Slope ☐ Upland ☒ Valley		<u>1069</u> <u>W 1/4 Sec 25 T 18 S R 15 NW</u>			
		20. Water well contractor's certification: This well was drilled under my jurisdiction and this report is true to the best of my knowledge and belief. <u>Kellys Water Well Ser. 186</u> Business name <u>R2 Great Bend, KS</u> License No. <u>1/4 1/4</u> Address <u>Great Bend, KS</u> Signed <u>Kelly Puze</u> Date <u>8-10-76</u> Authorized representative			