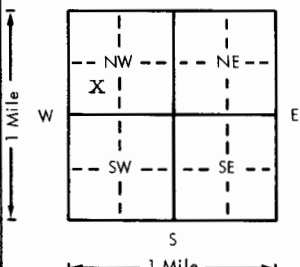


USE TYPEWRITER OR BALL
POINT PEN-PRESS FIRMLY,
PRINT CLEARLY.

WATER WELL RECORD
KSA 82a-1201-1215

Kansas Department of Health and
Environment-Division of Environment
(Water well Contractors)
Topeka, Kansas 66620

1. Location of well:		County Barton	Fraction C 1/4 SW 1/4 NW 1/4	Section number 27	Township number T 18 S	Range number R 15 E
2. Distance and direction from nearest town or city: 1-N 2-E of Albert, Ks. Street address of well location if in city:				3. Owner of well: Vernon Skolaut R.R. or street: none City, state, zip code: Olmitz, Kansas 67564		
4. Locate with "X" in section below: Sketch map: 				6. Bore hole dia. 29 in. Completion date _____ Well depth 93 1/2 ft. 6-30-75		
				7. ☐ Cable tool ☒ Rotary ☐ Driven ☐ Dug ☐ Hollow rod ☐ Jetted ☐ Bored ☐ Reverse rotary		
				8. Use: ☐ Domestic ☐ Public supply ☐ Industry ☒ Irrigation ☐ Air conditioning ☐ Stock ☐ Lawn ☐ Oil field water ☐ Other		
				9. Casing: Material steel Height: Above or below _____ Threaded _____ Welded _____ Surface 18 in. RMP _____ PVC _____ Weight _____ lbs./ft. Dia. 16 in. to 93 1/2 ft. depth Wall Thickness: inches or _____ Dia. _____ in. to _____ ft. depth Gauge No. 7		
5. Type and color of material				From	To	10. Screen: Manufacturer's name 20' doerrs 20' Johnson Type steel Dia. _____ Slot 3/16 Length 40 Set between 53 1/2 ft. and 93 1/2 ft. Gravel pack? ☒ Size range of material 3/4 3/8
top soil				0	2	11. Static water level: _____ mo./day/yr. 15 1/2 ft. below land surface Date 4-24-75
light & dark brown clay				2	20	12. Pumping level below land surfaces: 31 ft. after 1 hrs. pumping 800 g.p.m. _____ ft. after _____ hrs. pumping _____ g.p.m. Estimated maximum yield 1600+ g.p.m.
gray sticky clay				20	30	13. Water sample submitted: _____ mo./day/yr. ☒ Yes ☐ No Date 4-24-75
sandy blue gray green clay				30	35	14. Well head completion: ☐ Pitless adapter _____ Inches above grade
sand & gravel blue colored				35	43	15. Well grouted? ☒ With: ☒ Neat cement ☐ Bentonite ☐ Concrete Depth: From 0 ft. to 10 ft.
blue clay				43	47	16. Nearest source of possible contamination: ft. 1300 Direction north Type feedyard Well disinfected upon completion? ☒ Yes ☐ No
sand & gravel med. clean loose				47	60	17. Pump: ☒ Not installed Manufacturer's name _____ Model number _____ HP _____ Volts _____ Length of drop pipe _____ ft. capacity _____ g.p.m. Type: ☐ Submersible ☐ Turbine ☐ Jet ☐ Reciprocating ☐ Centrifugal ☐ Other
brown clay				60	61	
sand & gravel clean coarse loose				61	72	
sand & gravel w/some clay				72	75	
sand & gravel clean st coarse loose				75	92	
fire clay				92	93	
(Use a second sheet if needed)						
18. Elevation: 1910 Topography: W ☐ Hill ☐ Slope ☒ Upland ☐ Valley		19. Remarks:		20. Water well contractor's certification: This well was drilled under my jurisdiction and this report is true to the best of my knowledge and belief. Rosencrantz-Bemis 134 Business name License No. Address Great Bend, Ks. 67530 Signed S. Kilgore Date 6-19-79 Authorized representative		