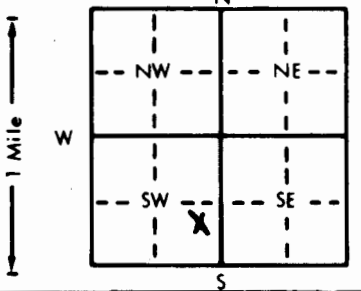


1 LOCATION OF WATER WELL:		Fraction	Section Number	Township Number	Range Number
County: <u>Barton</u>		<u>NE</u> $\frac{1}{4}$ <u>SE</u> $\frac{1}{4}$ <u>SW</u> $\frac{1}{4}$	<u>29</u>	<u>T</u> <u>18</u> <u>S</u>	<u>R</u> <u>15</u> <u>5W</u>
Distance and direction from nearest town or city street address of well if located within city? <u>East edge of Albert</u>					
2 WATER WELL OWNER: <u>Jerry Cross</u>					
RR#, St. Address, Box # : <u>Rt. 1, Box 10C</u>					
City, State, ZIP Code : <u>Albert, Ks. 67511</u>					
Board of Agriculture, Division of Water Resources Application Number:					
3 LOCATE WELL'S LOCATION WITH AN "X" IN SECTION BOX:		4 DEPTH OF COMPLETED WELL <u>70</u> ft. ELEVATION:			
		Depth(s) Groundwater Encountered 1. ft. 2. ft. 3. ft. WELL'S STATIC WATER LEVEL <u>33</u> ft. below land surface measured on mo/day/yr <u>5-1-91</u> Pump test data: Well water was ft. after hours pumping gpm Est. Yield <u>NA</u> gpm: Well water was ft. after hours pumping gpm Bore Hole Diameter <u>10</u> in. to <u>70</u> ft., and in. to ft. WELL WATER TO BE USED AS: 5 Public water supply 8 Air conditioning 11 Injection well 1 Domestic 3 Feedlot 6 Oil field water supply 9 Dewatering 12 Other (Specify below) 2 Irrigation 4 Industrial 7 Lawn and garden only 10 Monitoring well Was a chemical/bacteriological sample submitted to Department? Yes.....No <u>X</u>; If yes, mo/day/yr sample was submitted Water Well Disinfected? Yes <u>HTH</u> No			
5 TYPE OF BLANK CASING USED:					
1 Steel 3 RMP (SR) 5 Wrought iron 8 Concrete tile CASING JOINTS: Glued <u>X</u> Clamped 2 PVC 4 ABS 6 Asbestos-Cement 9 Other (specify below) Welded 7 Fiberglass Threaded					
Blank casing diameter <u>5</u> in. to <u>50</u> ft., Dia. in. to ft., Dia. in. to ft. Casing height above land surface <u>18</u> in., weight <u>258</u> lbs./ft. Wall thickness or gauge No.					
TYPE OF SCREEN OR PERFORATION MATERIAL:					
1 Steel 3 Stainless steel 5 Fiberglass 7 PVC 10 Asbestos-cement 2 Brass 4 Galvanized steel 6 Concrete tile 8 RMP (SR) 11 Other (specify) 9 ABS 12 None used (open hole)					
SCREEN OR PERFORATION OPENINGS ARE:					
1 Continuous slot 3 Mill slot 5 Gauzed wrapped 8 Saw cut 11 None (open hole) 2 Louvered shutter 4 Key punched 6 Wire wrapped 9 Drilled holes 7 Torch cut 10 Other (specify)					
SCREEN-PERFORATED INTERVALS: From <u>50</u> ft. to <u>70</u> ft., From ft. to ft. From ft. to ft., From ft. to ft.					
GRAVEL PACK INTERVALS: From <u>20</u> ft. to <u>70</u> ft., From ft. to ft. From ft. to ft., From ft. to ft.					
6 GROUT MATERIAL: 1 Neat cement 2 Cement grout 3 Bentonite 4 Other					
Grout Intervals: From <u>3</u> ft. to <u>20</u> ft., From ft. to ft., From ft. to ft.					
What is the nearest source of possible contamination:					
1 Septic tank 4 Lateral lines 7 Pit privy 10 Livestock pens 14 Abandoned water well 2 Sewer lines 5 Cess pool 8 Sewage lagoon 11 Fuel storage 15 Oil well/Gas well 3 Watertight sewer lines 6 Seepage pit 9 Feedyard 12 Fertilizer storage 16 Other (specify below) 13 Insecticide storage					
Direction from well? <u>west</u> How many feet? <u>60'</u>					
FROM	TO	LITHOLOGIC LOG	FROM	TO	PLUGGING INTERVALS
0	3	Top soil			
3	32	Brown clay			
32	69	Sand and gravel			
69	70	Yellow clay			
7 CONTRACTOR'S OR LANDOWNER'S CERTIFICATION: This water well was (1) constructed, (2) reconstructed, or (3) plugged under my jurisdiction and was completed on (mo/day/year) <u>5-1-91</u> and this record is true to the best of my knowledge and belief. Kansas Water Well Contractor's License No. <u>134</u> This Water Well Record was completed on (mo/day/yr) <u>6-26-91</u> under the business name of <u>Rosencrantz-Bemis Ent.</u> by (signature) <u>Judith Hedson</u>					