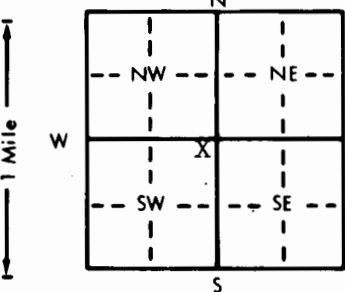


1 LOCATION OF WATER WELL:		Fraction	Section Number	Township Number	Range Number
County: Barton		NE 1/4 NE 1/4 SW 1/4	29	T 18 S	R 15
Distance and direction from nearest town or city street address of well if located within city? Approx. on the North Edge of the City of Albert, KS					
2 WATER WELL OWNER:		City of Albert			
RR#, St. Address, Box # :		c/o City Clerk			
City, State, ZIP Code :		Albert KS 67511			
3 LOCATE WELL'S LOCATION WITH AN "X" IN SECTION BOX:		4 DEPTH OF COMPLETED WELL: 83 ft. ELEVATION: 1915.190 unknown			
		Depth(s) Groundwater Encountered 1. 24'6" ft. 2. 1A' ft. 3. 1A' ft.			
		WELL'S STATIC WATER LEVEL 24'6" ft. below land surface measured on mo/day/yr 12/23/82			
		Pump test data: Well water was not ck'd. ft. after hours pumping gpm			
		Est. Yield unknown gpm: Well water was ft. after hours pumping gpm			
		Bore Hole Diameter 20 in. to 83 ft. and in. to ft.			
		WELL WATER TO BE USED AS: 5 Public water supply 8 Air conditioning 11 Injection well			
		1 Domestic 3 Feedlot 6 Oil field water supply 9 Dewatering 12 Other (Specify below)			
		2 Irrigation 4 Industrial* 7 Lawn and garden only 10 Observation well *Rural Fire Protection			
		Was a chemical/bacteriological sample submitted to Department? Yes No X; If yes, mo/day/yr sample was submitted			
		Water Well Disinfected? Yes XX No			
5 TYPE OF BLANK CASING USED:		CASING JOINTS: Glued XX Clamped			
1 Steel 3 RMP (SR) 5 Wrought iron 8 Concrete tile		Welded			
2 PVC 4 ABS 6 Asbestos-Cement 9 Other (specify below)		Threaded			
7 Fiberglass					
Blank casing diameter 8 in. to 53 ft. Dia. in. to ft. Dia. in. to ft.					
Casing height above land surface 12 in. weight 5,465 lbs./ft. Wall thickness or gauge No. 332					
TYPE OF SCREEN OR PERFORATION MATERIAL:		7 PVC 10 Asbestos-cement			
1 Steel 3 Stainless steel 5 Fiberglass 8 RMP (SR) 11 Other (specify)					
2 Brass 4 Galvanized steel 6 Concrete tile 9 ABS 12 None used (open hole)					
SCREEN OR PERFORATION OPENINGS ARE:		5 Gauzed wrapped 8 Saw cut 11 None (open hole)			
1 Continuous slot 3 Mill slot 6 Wire wrapped 9 Drilled holes					
2 Louvered shutter 4 Key punched 7 Torch cut 10 Other (specify)					
SCREEN-PERFORATED INTERVALS: From 53 ft. to 83 ft. From ft. to ft. From ft. to ft. From ft. to ft.					
GRAVEL PACK INTERVALS: From 22 ft. to 83 ft. From ft. to ft. From ft. to ft. From ft. to ft.					
Annular Fill From 10 ft. to 22 ft. From ft. to ft. From ft. to ft. From ft. to ft.					
6 GROUT MATERIAL: 1 Neat cement 2 Cement grout 3 Bentonite 4 Other					
Grout Intervals: From 0 ft. to 10 ft. From ft. to ft. From ft. to ft. From ft. to ft.					
What is the nearest source of possible contamination:		10 Livestock pens 14 Abandoned water well			
1 Septic tank 4 Lateral lines 7 Pit privy 11 Fuel storage 15 Oil well/Gas well					
2 Sewer lines 5 Cess pool 8 Sewage lagoon 12 Fertilizer storage 16 Other (specify below)					
3 Watertight sewer lines 6 Seepage pit 9 Feedyard 13 Insecticide storage none known--FIELD					
Direction from well? all		How many feet?			
FROM	TO	LITHOLOGIC LOG	FROM	TO	LITHOLOGIC LOG
0	32	Topsoil & brown clay			
32	37	Sand & gravel, med. - clean			
37	41	Soft brown clay			
41	47	Sand & gravel, med. medium , - clean			
47	49	Very soft green clay			
49	57	Sand & gravel, med. to fine, clean			
57	59	Green clay			
59	81	Sand & gravel, med. to coarse w/ streak of clay @ 79' & 80'			
81	83	Dakota clay			
7 CONTRACTOR'S OR LANDOWNER'S CERTIFICATION: This water well was (1) constructed, (2) reconstructed, or (3) plugged under my jurisdiction and was completed on (mo/day/year) 12/23/82 and this record is true to the best of my knowledge and belief. Kansas Water Well Contractor's License No. 185 This Water Well Record was completed on (mo/day/yr) 1/7/83 under the business name of CLARKE WELL & EQ., INC. by (signature)					
INSTRUCTIONS: Use typewriter or ball point pen, PLEASE PRESS FIRMLY and PRINT clearly. Please fill in blanks, underline or circle the correct answers. Send top three copies to Kansas Department of Health and Environment, Division of Environment, Environmental Geology Section, Topeka, KS 66620. Send one to WATER WELL OWNER and retain one for your records.					

OFFICE USE ONLY

T

18

R

15

ENV

SEC 29

NE

1/4

NE

1/4

SW

1/4