USE TYPEWRITER OR BALL POINT PEN-PRESS FIRMLY, PRINT CLEARLY.

WATER WELL RECORD
KSA 82a-1201-1215

Kansas Department of Health and Environment-Division of Environment
(Water well Contractors)
Topeka, Kansas 66620

1. Location of well:	County	Fraction	Section number	Township number	Range number
	Barton	NE 1/4 NE 1/4 NE 1/4	35	T 18 S	R 15 E (W)

2. Distance and direction from nearest town or city: From Heizer Ks. 2½ west 2 north
Street address of well location if in city: west side

3. Owner of well: Harold L. Cambell
R.R. or street: 1900 McKinney
City, state, zip code: Great Bend, Ks. 67530

4. Locate with "X" in section below: Sketch map:

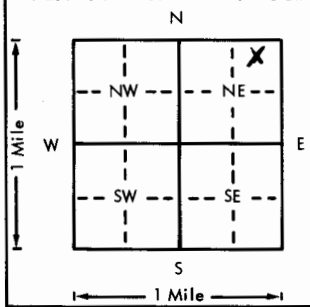

6. Bore hole dia. 24 in. Completion date
Well depth 75 ft. 4-1-77

7. ___ Cable tool X Rotary ___ Driven ___ Dug
___ Hollow rod ___ Jetted ___ Bored ___ Reverse rotary

8. Use: ___ Domestic ___ Public supply ___ Industry
X Irrigation ___ Air conditioning ___ Stock
___ Lawn ___ Oil field water ___ Other

9. Casing: Material Steel Height: Above or ~~below~~
Threaded ___ Welded X Surface 18 in.
RMP ___ PVC ___ Weight ___ lbs./ft.
Dia. 16 in. to 75 ft. depth Wall Thickness: inches or
Dia. ___ in. to ___ ft. depth gage No. 7

5. Type and color of material	From	To
Top soil	0	3
Clay	3	22
Soft clay	22	33
Soft sandy clay	33	36
Sand and Black Mud	36	38
Good clean sand gravel	38	55
Clay	55	67
Good clean gravel	67	73
Hard rock	73	
(Use a second sheet if needed)		

10. Screen: Manufacturer's name Dicos
Type Steel Dia. 16"
Slot ~~gauze~~ 3116 Length 28'
Set between 47 ft. and 75 ft.
___ ft. and ___ ft.
Gravel pack? X Size range of material ~~3/4~~ 7/8

11. Static water level: mo./day/yr.
20 ft. below land surface Date 3-9-77

12. Pumping level below land surfaces:
43 ft. after 1 hrs. pumping 600 g.p.m.
___ ft. after ___ hrs. pumping ___ g.p.m.
Estimated maximum yield 800 g.p.m.

13. Water sample submitted: mo./day/yr.
___ Yes X No Date

14. Well head completion:
___ Pitless adapter ___ Inches above grade

15. Well grouted? X
With: X Neat cement ___ Bentonite ___ Concrete
Depth: From 0 ft. to 10 ft.

16. Nearest source of possible contamination:
ft. 800 Direction East Type gas well
Well disinfected upon completion? ___ Yes ___ No

17. Pump: X Not installed
Manufacturer's name
Model number HP Volts
Length of drop pipe ft. capacity g.p.m.
Type:
___ Submersible ___ Turbine
___ Jet ___ Reciprocating
___ Centrifugal ___ Other

18. Elevation: 1973
Topography:
___ Hill
X Slope
X Upland
___ Valley

19. Remarks:

20. Water well contractor's certification:
This well was drilled under my jurisdiction and this report is true to the best of my knowledge and belief.
Rosencrantz-Pemis 134
Business name License No.
Address Great Bend, Ks 67530
Signed Sandy Kilgore Date 7-11-77
Authorized representative

T 18 R 15 (W) E Sec 35 NE 1/4 NE 1/4 NE 1/4

Forward the white, blue and pink copies to the Department of Health and Environment

Form WWC-5