


MW#7  
the Number

**INSTRUCTIONS:** Use typewriter or ballpoint pen. **PLEASE PRESS HEAVILY AND PRINT** clearly. Please fill in blanks, underline or circle the correct answer. Send this WWSL to Kansas Department of Health and Environment, Bureau of Water, Topeka, Kansas 66603-0007. Telephone 785-236-0824. Send one to **WATER WELL OWNER** and retain one for your records. Fee of \$5.00 for each completed well.

INSTRUCTIONS: Use typewriter or ball point pen. PLEASE PRESS FIRMLY and PRINT clearly. Please fill in blanks, underline or circle the correct answers. Send top three copies to Kansas Department of Health and Environment, Bureau of Water, Topeka, Kansas 66620-0001. Telephone 785-296-5524. Send one to WATER WELL OWNER and retain one for your records. Fee of \$5.00 for each constructed well.

*Barton County*

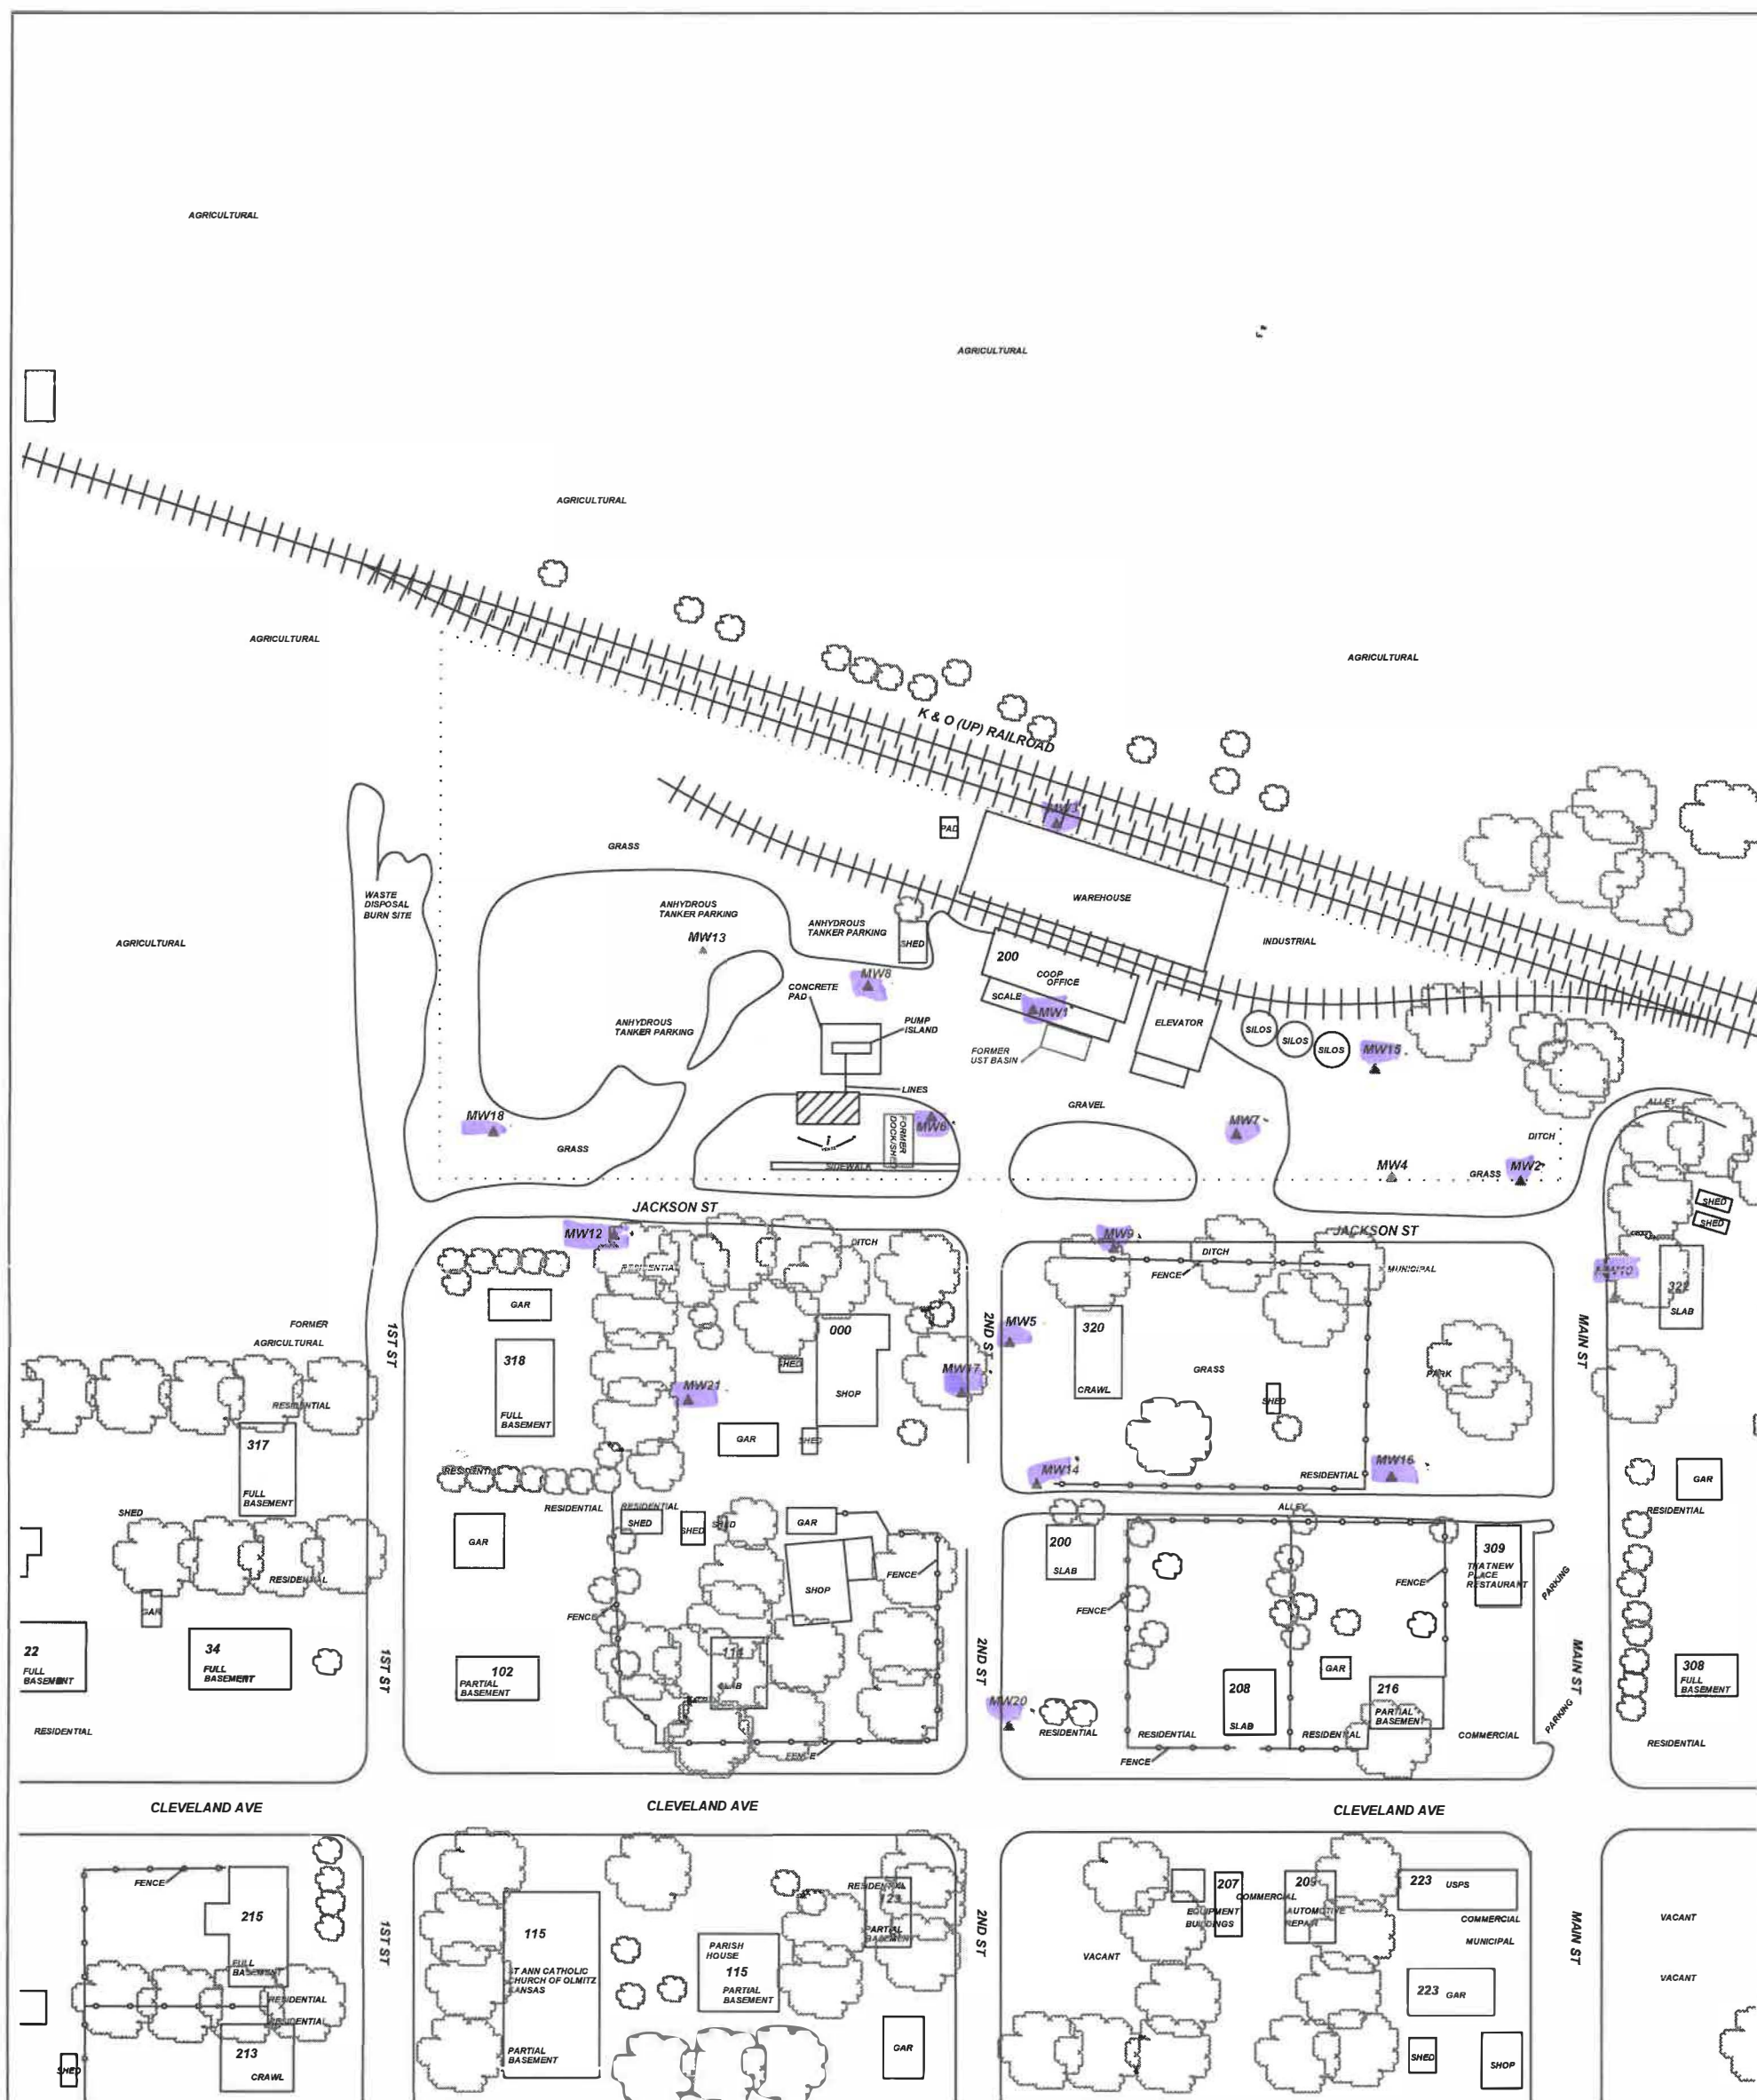

**NOTES:**

**ASSOCIATED  
ENVIRONMENTAL  
INC.**

••••• = **SUBJECT PROPERTY**

RECEIVED  
APR 07 2023  
BUREAU OF WATER